

LEGEND

- | | |
|----------------------------|---------------------------------|
| ● SOIL SAMPLE | ▲ BACKGROUND SOIL SAMPLE |
| ● SOIL SCREENING LOCATION | ⊕ GROUNDWATER SAMPLE |
| ● SHALLOW SOIL VAPOR POINT | ■ FORMER WELLHEAD |
| ■ POTHOLE SOIL SAMPLE | — APPROXIMATE FLOWLINE LOCATION |
| | ▭ EXCAVATION EXTENT |

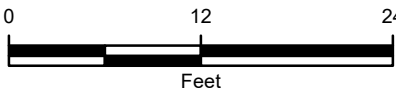


FIGURE 1
EXCAVATION SITE MAP
SCHMID 2-34 WELLHEAD
NWNE SEC 34-T4N-R66W
WELD COUNTY, COLORADO
KERR-MCGEE OIL & GAS ONSHORE, LP

