MULL DRILLING COMPANY, INC.
WICHITA, KANSAS

Current Wellbore Diagram

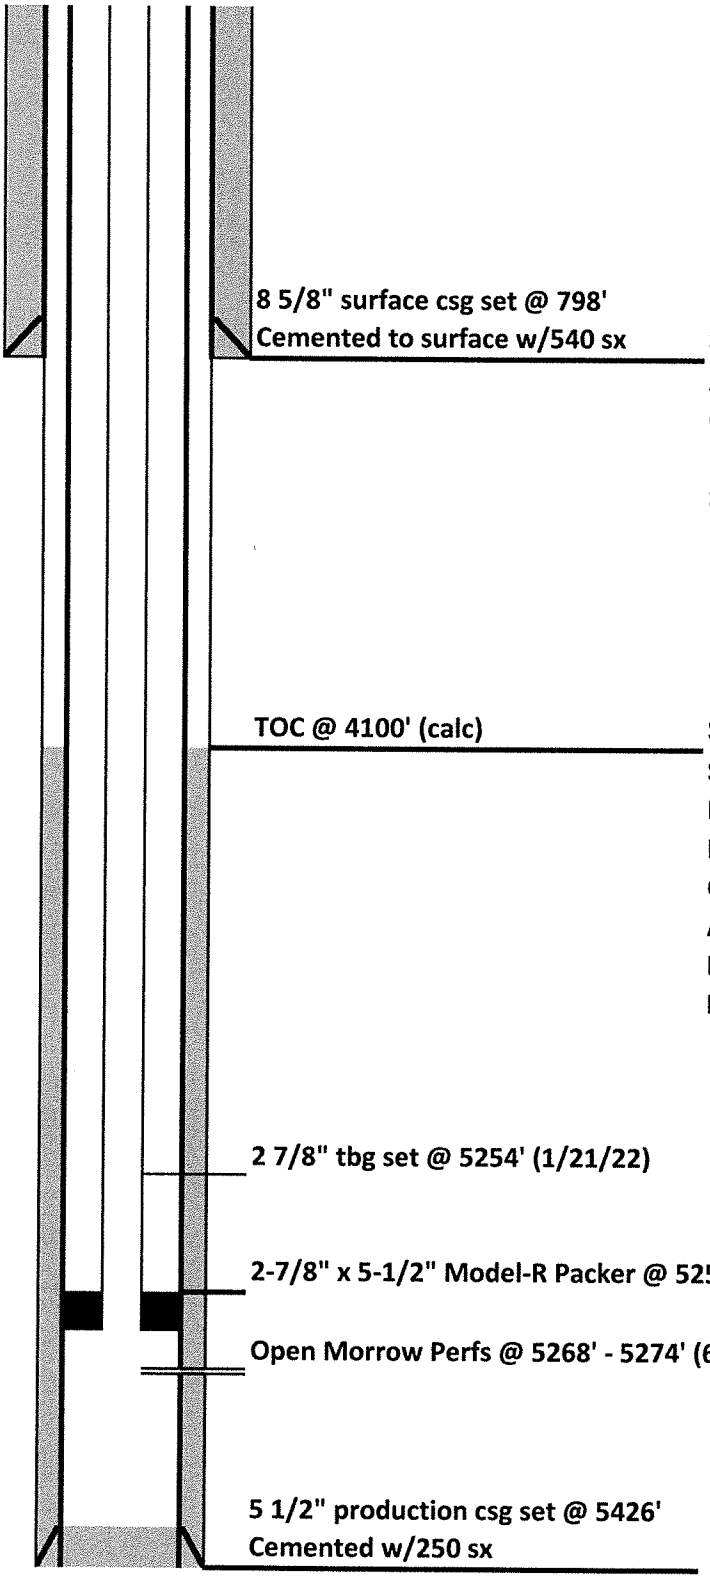

PBTD = 5295'
RTD = 5426'

Date:	2/16/2022
Well Name:	NWAU #14
F/K/A:	Howard 44-31 #6
Former Op:	UPRC
Date of Xfer:	12/31/1991
Location:	460' FSL & 460' FEL
	SE/4 SE/4 31-13S-42W
County:	Cheyenne
State:	Colorado
API:	05-017-07088
GL:	4036'
KB:	4046'
Spud Date:	12/12/1989
DFP Morrow:	1/18/1990

Formation	Log Top
STONE CORRAL	3017
SHAWNEE	4090
LANSING	4350
MARMATON	4734
CHEROKEE K	4896
ATOKA	5046
MORROW	5186
KEYES	5327