




RECEIVED

AUG 21 1968

R. 90 W

COLO. OIL & GAS CONS. COMM.

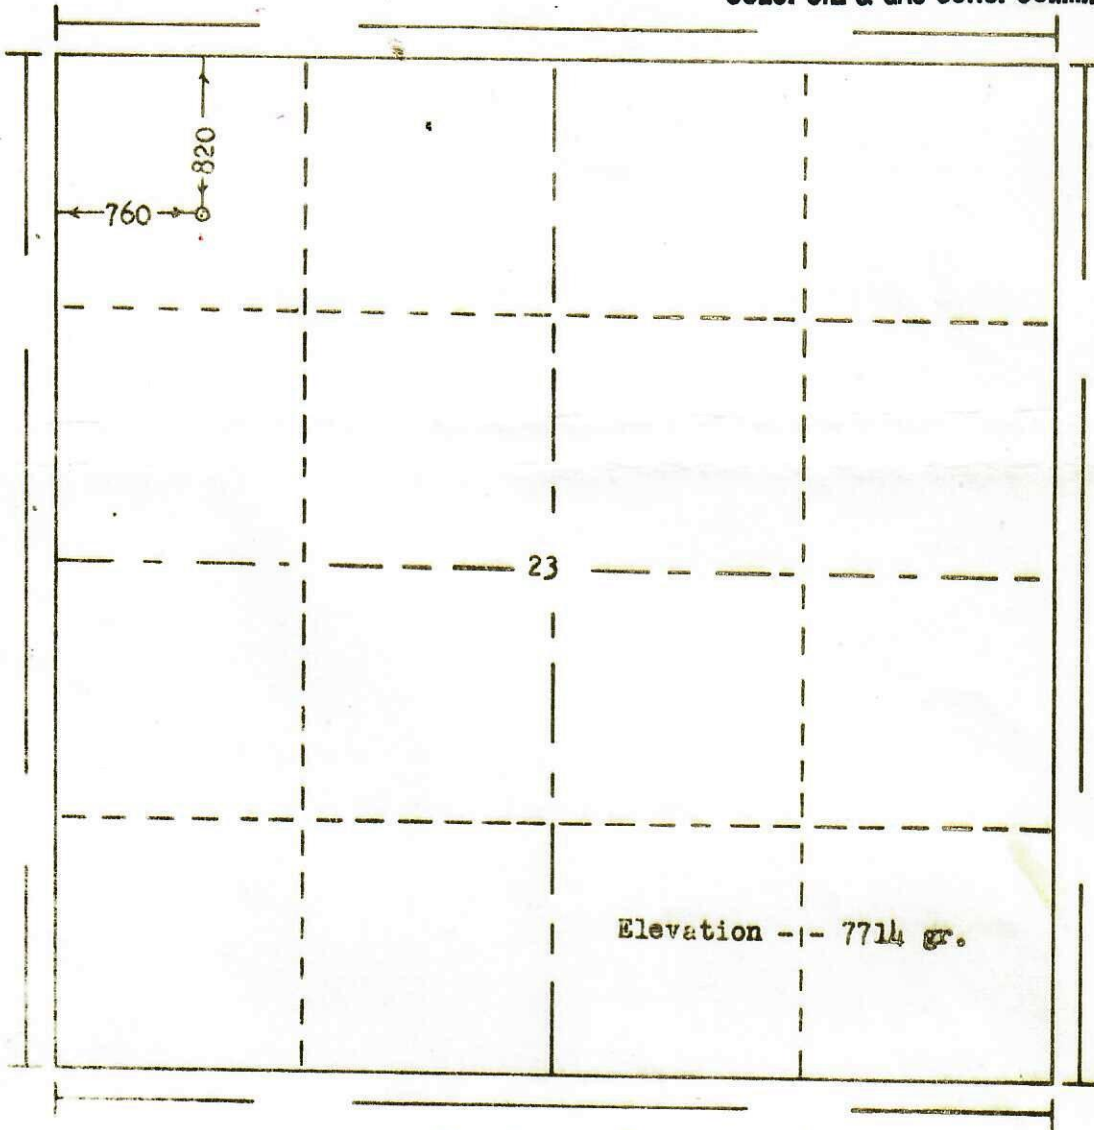

T.
9
N

Scale... 1" = 1000'

Powers Elevation Company, Inc. of Denver, Colorado
has in accordance with a request from Mr. Pomeroy
for Occidental Petroleum

determined the location of # 1 Government-Belco

to be 820FN & 760FW

Section 23 Township 9 N

Range 90 W of the Sixth Principle
Moffat

Meridian

County, Colorado

I hereby certify that this plat is an
accurate representation of a correct
survey showing the location of
1 Government-Belco

68-305

Date: 8-13-68

T. Nelson
Licensed Land Surveyor No.
State of Colorado

