


**Well Name: UNI UPR C25-05**

VERTICAL, ORIGINAL HOLE, 2/28/2022 10:21:33 AM

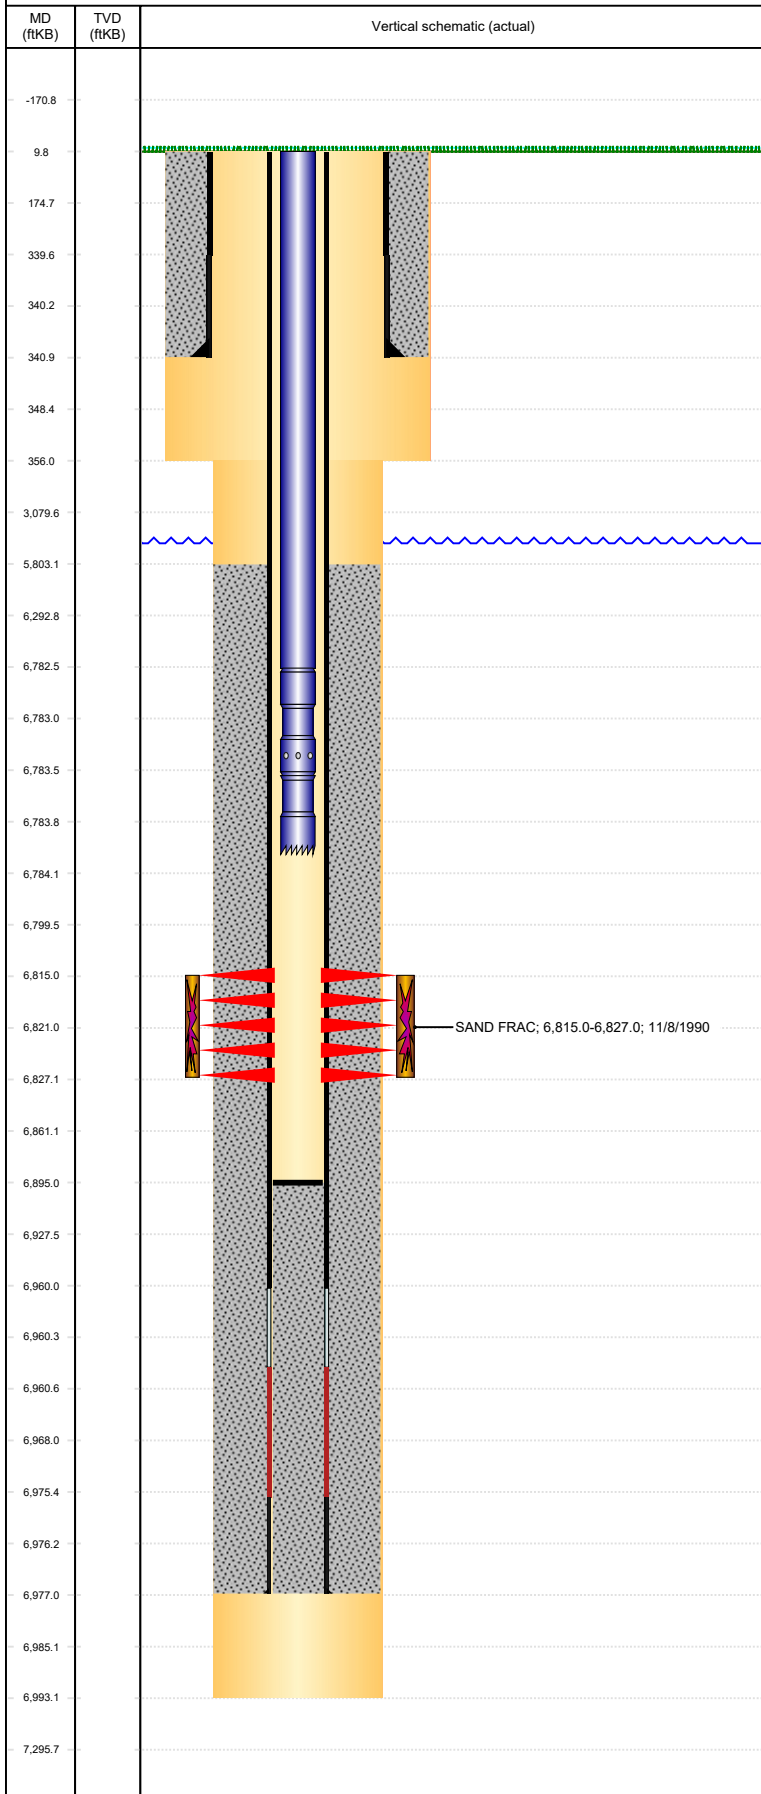

## Well Header

|                                     |                               |                         |                         |
|-------------------------------------|-------------------------------|-------------------------|-------------------------|
| API<br>05-123-14777                 | Business Unit<br>DJ BASIN     | District<br>15          | Well Config<br>VERTICAL |
| Original KB Elevation (ft)<br>4,710 | KB - GL / MSL (ftKB)<br>10.00 | Spud Date<br>10/10/1990 | P & A Date              |

## Comment

DISCREPANCY IN TD: DRL RPT & DEPTH LOGGER 6993', ST RPT 6990'

## Directions To Well

WCR 40 & WCR 57, SOUTH 1 MILE (3600) EAST 1.3 MILES, NORTH 0.8 MILES, WEST 0.3 MILES, NORTH 0.2 MILES, EAST & NORTH 0.6 MILES, EAST 0.1 MILES, NORTH INTO

## Congressional Location

|                 |                 |               |               |               |             |                    |
|-----------------|-----------------|---------------|---------------|---------------|-------------|--------------------|
| Quarter 3<br>SW | Quarter 4<br>NW | Section<br>25 | Township<br>4 | TwNS Dir<br>N | Range<br>64 | Range E/W Dir<br>W |
|-----------------|-----------------|---------------|---------------|---------------|-------------|--------------------|

## Bottom Hole Legal Location

Bottom Hole Legal Location

## Plug Back Total Depths

| Date       | Depth (ftKB) | Method         | Com  |
|------------|--------------|----------------|--|
| 10/14/1990 | 6,960.0      | CASING TALLY   | TOP OF FLOAT COLLAR                          |
| 10/23/1990 | 6,895.0      | CASED HOLE LOG | DEPTH LOGGER ON CBL                          |
| 1/29/1999  | 6,890.0      | TAG            | CLEAN OUT                                    |
| 4/6/2011   | 6,789.0      | TAG            |  |
| 4/7/2011   | 6,895.0      | TUBING TALLY   | CLEAN OUT TO THIS POINT. VERY HARD. 70" O... |

## Wellbore Sections

| Section Des | Size (in) | Act Top, MD (ftKB) | Act Btm, MD (ftKB) |
|-------------|-----------|--------------------|--------------------|
| SURFACE     | 12 1/4    | 10                 | 356                |
| PRODUCTION  | 7 7/8     | 356                | 6,993              |

## Zone Statuses

| Zone Name | Status Date | Status | Fluid Type | Job            | Prod Method |
|-----------|-------------|--------|------------|----------------|-------------|
| CODELL    | 11/13/1990  | PR     |            | DRILLING/CO... |             |
| CODELL    | 11/13/1990  | PR     | Oil        |                | Flowing     |
| CODELL    | 6/5/2009    | PR     | Water      |                | Flowing     |

## Casing Strings

### Surface, 341.0ftKB

| Casing Description | Run Date   | OD (in) | Wt/Len (l...) | Grade | Top, MD (ft...) | MD (ftKB) |
|--------------------|------------|---------|---------------|-------|-----------------|-----------|
| Surface            | 10/10/1990 | 8 5/8   | 24.00         |       | 10.0            | 341.0     |

### Production, 6,977.0ftKB

| Casing Description | Run Date   | OD (in) | Wt/Len (l...) | Grade | Top, MD (ft...) | MD (ftKB) |
|--------------------|------------|---------|---------------|-------|-----------------|-----------|
| Production         | 10/14/1990 | 2 7/8   | 6.50          | N-80  | 10.0            | 6,977.0   |

## Cement

| Description              | Top Depth (ftKB) | Bottom Depth (ftKB) |
|--------------------------|------------------|---------------------|
| Surface Casing Cement    | 10.0             | 341.0               |
| Description              | Top Depth (ftKB) | Bottom Depth (ftKB) |
| Production Casing Cement | 5,803.0          | 6,977.0             |

## Tubing Strings

| Tubing Description | Run Date  | String... | ID (in) | Wt (lb/ft) | Grade | Len (ft) | Set De... |
|--------------------|-----------|-----------|---------|------------|-------|----------|-----------|
| Tubing             | 1/29/1999 |           |         |            |       |          |           |

## Tubing Components

| Item Des            | OD (in)  | Wt (lb/ft) | Grade   | Jts        | Len (ft) | Btm (ftKB) | Btm (TVD) (ftKB) |
|---------------------|----------|------------|---------|------------|----------|------------|------------------|
|                     | 1 1/2    | 2.76       |         | 210        |          | 6,802.0    |                  |
| Tubing Description  | Run Date | String...  | ID (in) | Wt (lb/ft) | Grade    | Len (ft)   | Set De...        |
| Tubing - Production | 4/8/2011 | 1.66       | 1.38    | 2.33       | J-55     | 6,774.00   |                  |

## Tubing Components

| Item Des            | OD (in) | Wt (lb/ft) | Grade | Jts | Len (ft) | Btm (ftKB) | Btm (TVD) (ftKB) |
|---------------------|---------|------------|-------|-----|----------|------------|------------------|
| Tubing              | 1.66    | 2.33       | J-55  | 206 | 6,772.50 | 6,782.5    |                  |
| Pump Seating Nipple | 1.66    |            |       |     | 1.00     | 6,783.5    |                  |
| Notched collar      | 1.66    |            |       |     | 0.50     | 6,784.0    |                  |

## Other In Hole


| Run Date | Des | Make | OD (in) | Top (ftKB) | Btm (ftKB) | Pr op R un o |
|----------|-----|------|---------|------------|------------|--------------|
|          |     |      |         |            |            |              |

## Logs

| Date       | Type                | Top, MD (ftKB) | Btm, MD (ftKB) |
|------------|---------------------|----------------|----------------|
| 10/14/1990 | COMPENSATED DENSITY | 6,096.0        | 6,972.0        |
| 10/23/1990 | CBL/CCL/GR          | 5,700.0        | 6,890.0        |

**Well Name: UNI UPR C25-05**

VERTICAL, ORIGINAL HOLE, 2/28/2022 10:21:34 AM

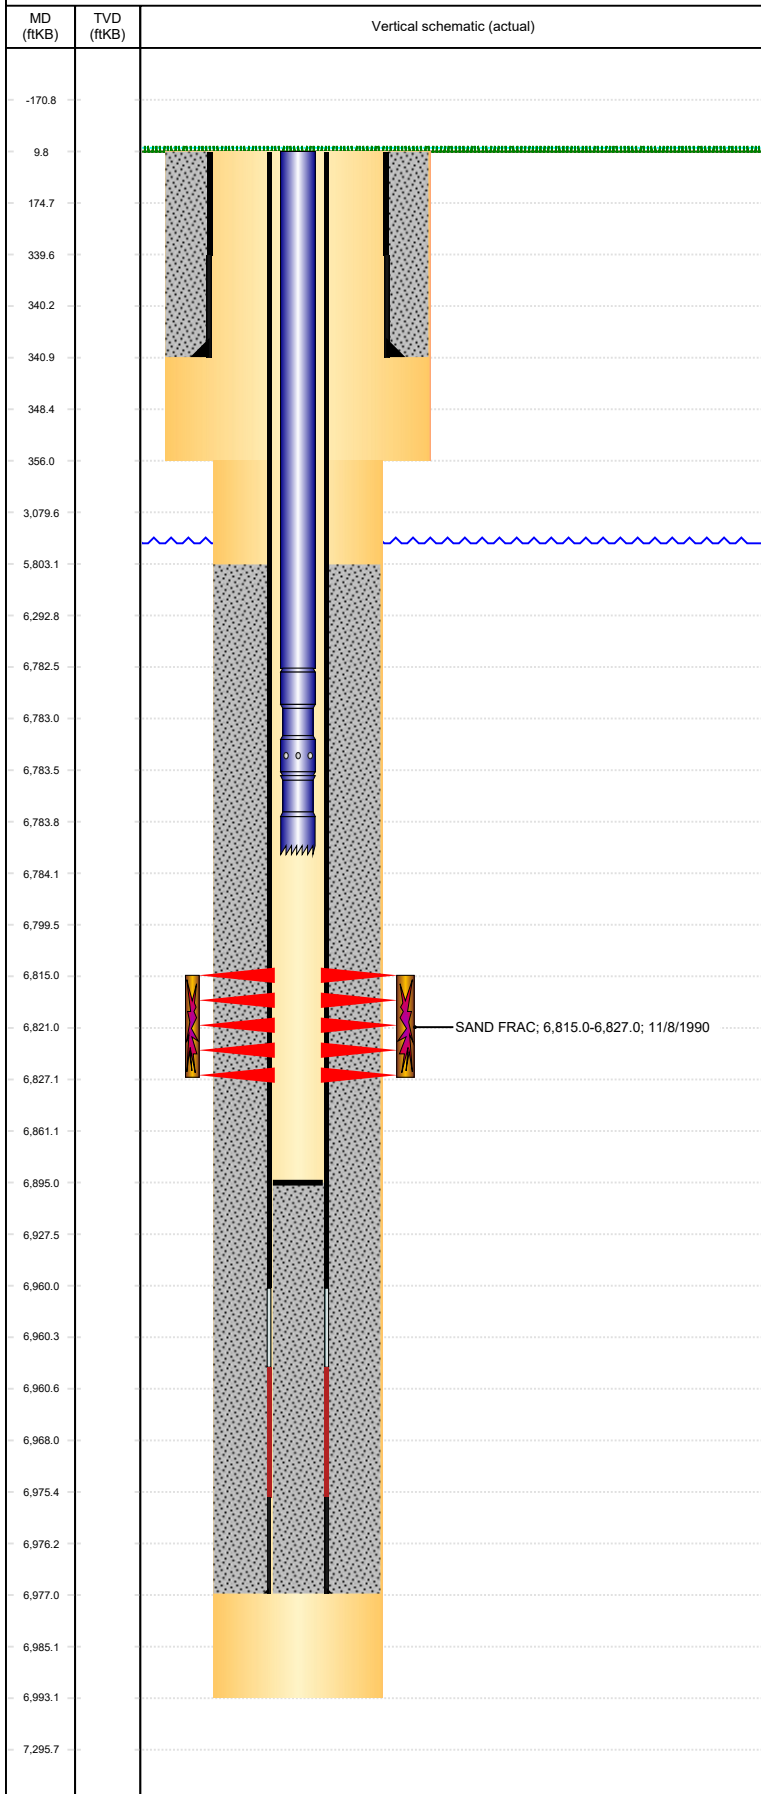

| Logs                  |              |                                 |                |                       |            |
|-----------------------|--------------|---------------------------------|----------------|-----------------------|------------|
| Date                  | Type         |                                 | Top, MD (ftKB) | Btm, MD (ftKB)        |            |
| 4/6/2011              | GYRO         |                                 | 10.0           | 6,977.0               |            |
| Perforation Data      |              |                                 |                |                       |            |
| Linked Zone           | Bnch/St<br>g | Sum of<br>Entered<br>Shot Total | Top (ftKB)     | Btm (ftKB)            | Date       |
| CODELL, ORIGINAL HOLE |              | 26                              | 6,815.00       | 6,827.00              | 10/23/1990 |
| Total                 |              | 26                              |                |                       |            |
| Stimulation Intervals |              |                                 |                |                       |            |
| Interval...           | Start Date   | Primary Job Type                |                | Zone                  |            |
| 1                     | 11/8/1990    | DRILLING/COMPLETION - ORIGINAL  |                | CODELL, ORIGINAL HOLE |            |
| Technical Result      |              | Tech Result Details             |                | Tech Result Note      |            |
| Comment               |              |                                 |                |                       |            |