


**Well Name: ROUSE USX AB31-08**

VERTICAL, ORIGINAL HOLE, 2/23/2022 10:32:15 AM

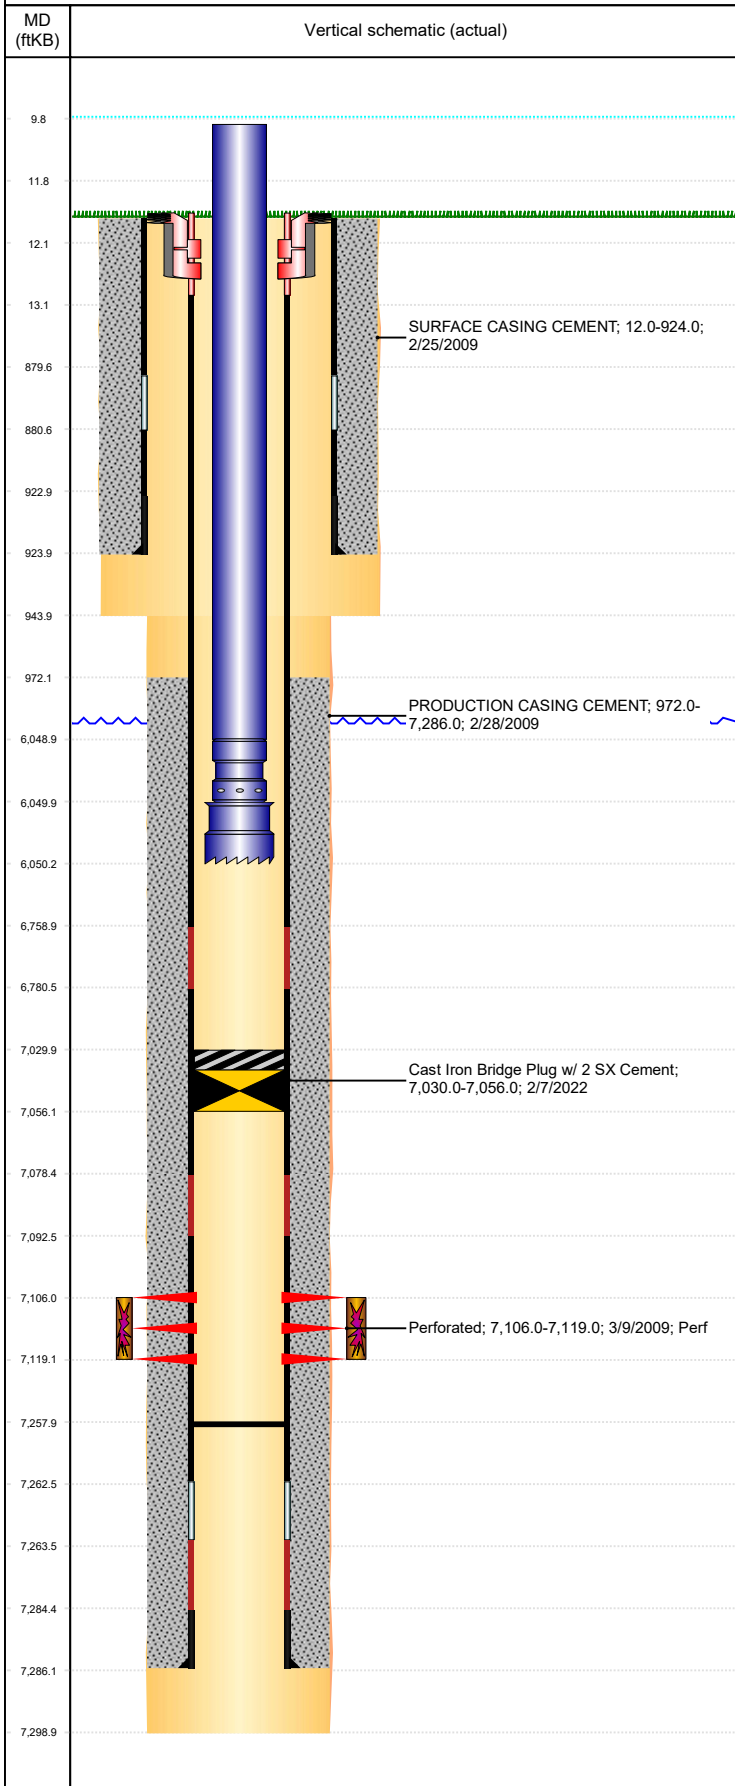

Well Header									
API 05-123-29406		Business Unit DJ BASIN			District 15		Well Config VERTICAL		
KB - GL / MSL (ft... 12.00		Spud Date 2/24/2009		P & A Date		Well Production Status TA			SoRT Yes
Comment									
Surface Location (Congressional)									
Qtr 3 SE	Qtr 4 NE	Section 31	Twonshp 7	Twonsh... N	Range 64	Rng E/... W	Actual Latitude (°) 40.53094612	Actual Longitude (°) -104.58555944	
Wellbore Sections									
Section Des			Size (in)			Act Top, MD (ftKB)		Act Btm, MD (ftKB)	
SURFACE			12 1/4			12		944	
PRODUCTION			7 7/8			944		7,299	
Casing Strings									
Csg Des		Run Date		OD (in)	Wt/Len (lb/ft)	Grade	Top, MD (ftKB)	MD (ftKB)	
Surface		2/25/2009		8 5/8	24.00	J-55	12.0	924.0	
PRODUCTION		2/28/2009		4 1/2	11.60	M-80	12.0	7,286.0	
Cement									
Des				Start Date		Top (ftKB)		Btm (ftKB)	
SURFACE CASING CEMENT				2/25/2009		12.0		924.0	
PRODUCTION CASING CEMENT				2/28/2009		972.0		7,286.0	
Zone Statuses									
Zone Name	Status Date	Status	Fluid Type	Job			Prod Method		
CODELL	3/25/2009	PR		DRILLING/COMPLETION - ORIGINAL, 2/23/2009...					
CODELL	2/7/2022	TA		CIBP, 2/7/2022 06:00					
Perforation Data									
Linked Zone		Bnch/Stg	Entered Shot Total	Top (ftKB)		Btm (ftKB)		Date	
CODELL, ORIGINAL HOLE			52	7,106.00		7,119.00		3/9/2009	
Stimulation Intervals									
Zone			Start Date		Top (ftKB)		Btm (ftKB)		
CODELL, ORIGINAL HOLE			3/17/2009		7,106.0		7,119.0		
Other In Hole									
Run Date	Des			Make	OD (in)	Top (ftKB)	Btm (ftKB)		
2/7/2022	Cast Iron Bridge Plug w/ 2 SX Cement				4	7,030.0	7,056.0		
Logs									
Date		Type				Top, MD (ftKB)		Btm, MD (ftKB)	
2/28/2009		Caliper/comp. Density/Neutron/GR/SP/ML				2,750.0		7,285.0	
2/28/2009		DIL/GR/SP/Caliper				930.0		7,305.0	
3/6/2009		CBL/CCL/GR				790.0		7,257.0	
Plug Back Total Depths									
Date		Type		Com				Depth (ftKB)	
2/28/2009		FLOAT COLLAR						7,262.0	
3/6/2009		FILL						7,258.0	