


CERTIFICATE OF SURVEY
for
Sundance Oil Co.
Logan County, Colorado

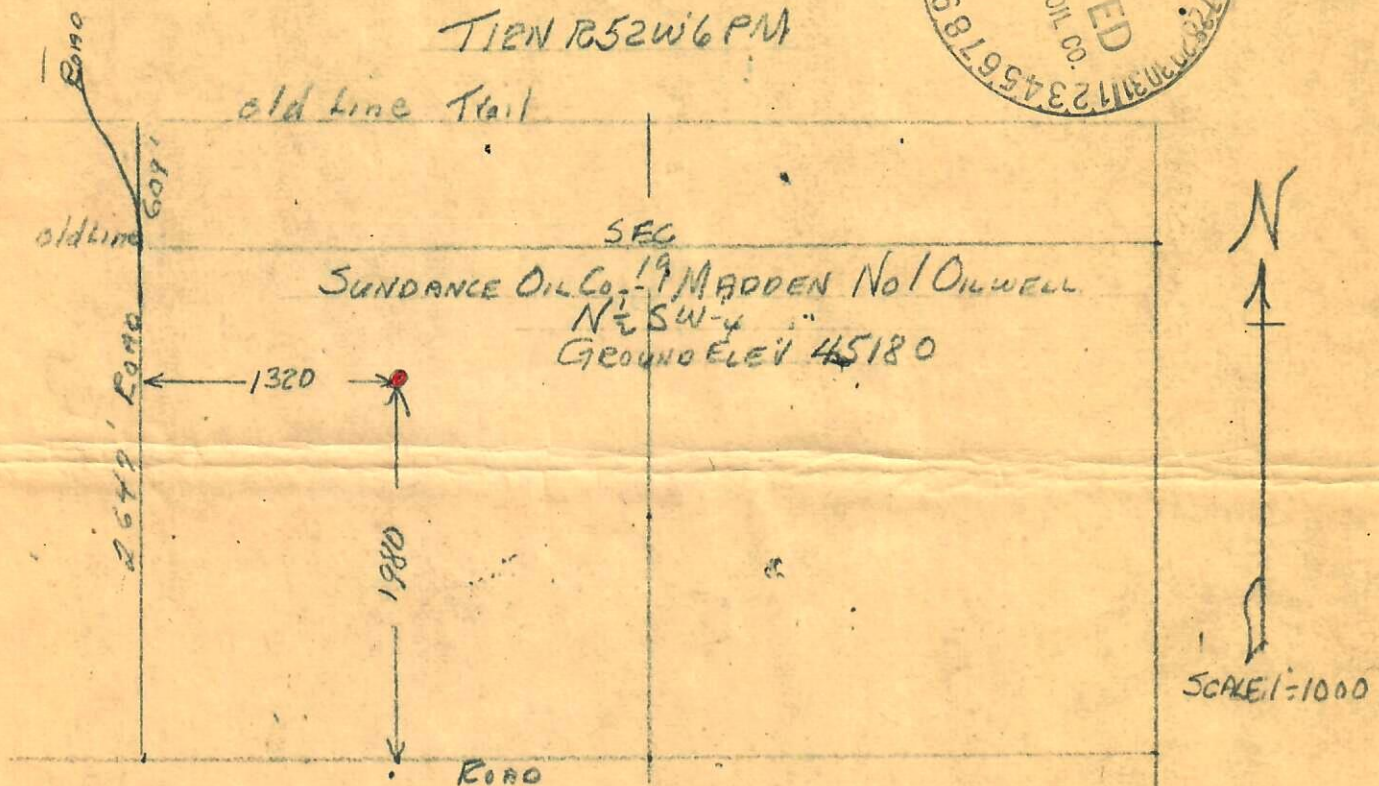

I hereby certify that the above plat is an accurate representation of a correct survey showing the location of Sundance Oil Co.-Madden No.1 Oilwell in N $\frac{1}{2}$ SW $\frac{1}{4}$ Sec.19 T12N R52W 6PM. The elevation of the ground at the stake is 4518.0 feet above sea level from U.S.C.S. Bench Mark.

Fort Morgan, Colorado
Dec. 19, 1968

Bevil Osborne
Registered Professional Engineer,
State of Colorado

RECEIVED

JAN 29 1969

COLO. OIL & GAS CONS. COMM.



00290637