


WELL LOCATION PLAT

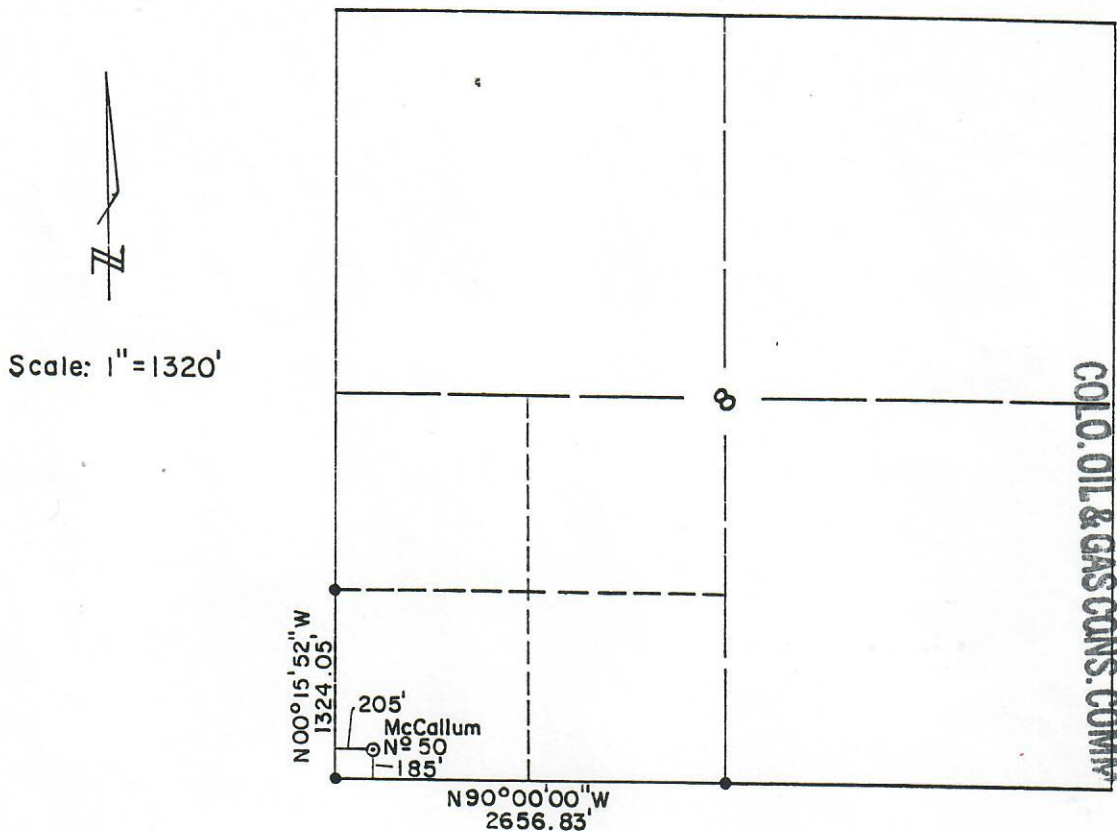

00265479

CONOCO, INC. McCALLUM WELL NO. 50
LOCATED IN THE SW. 1/4, SW. 1/4, SECTION 8, T9N, R78W, OF THE 6TH P.M.
JACKSON COUNTY, COLORADO



JUL 08 1991

RECEIVED

NOTE: Basis of bearing is assumed bearing of N 90°00'00" W on the South line of the SW. 1/4 of Section 8.

- - Found GLO Brass Cap.

I, Brian T. Nelson, of Fort Collins, Colorado, do hereby certify that in accordance with a request from Ted Kelly of Casper, Wy. for Conoco, Inc. I made a survey on May 17, 1991, for the location and elevation of the above well. As shown on the above map, the well site is in the SW. 1/4 of the SW. 1/4 of Section 8, Township 9 North, Range 78 West of the 6th Principal Meridian, Jackson County, Colorado. The elevation is 8145 feet, ungraded ground at the SW. Corner of said Section 8. Elevation datum is a spot elevation on a U.S.G.S. Topographic map.

REFERENCE POINT 250' North, elevation = 8163.0 feet.
REFERENCE POINT 250' South, elevation = 8155.4 feet.
REFERENCE POINT 250' East, elevation = 8148.9 feet.
REFERENCE POINT 250' West, elevation = 8145.5 feet.

EXHIBIT I

Brian T. Nelson
Colorado R.L.S. 23513

Prepared by Resource Consultants, Inc., 402 W. Mountain Ave., Ft. Collins.
CO. 80521 Job No. 91-614.0