


SECTION 1 TOWNSHIP 12 S RANGE 51 W

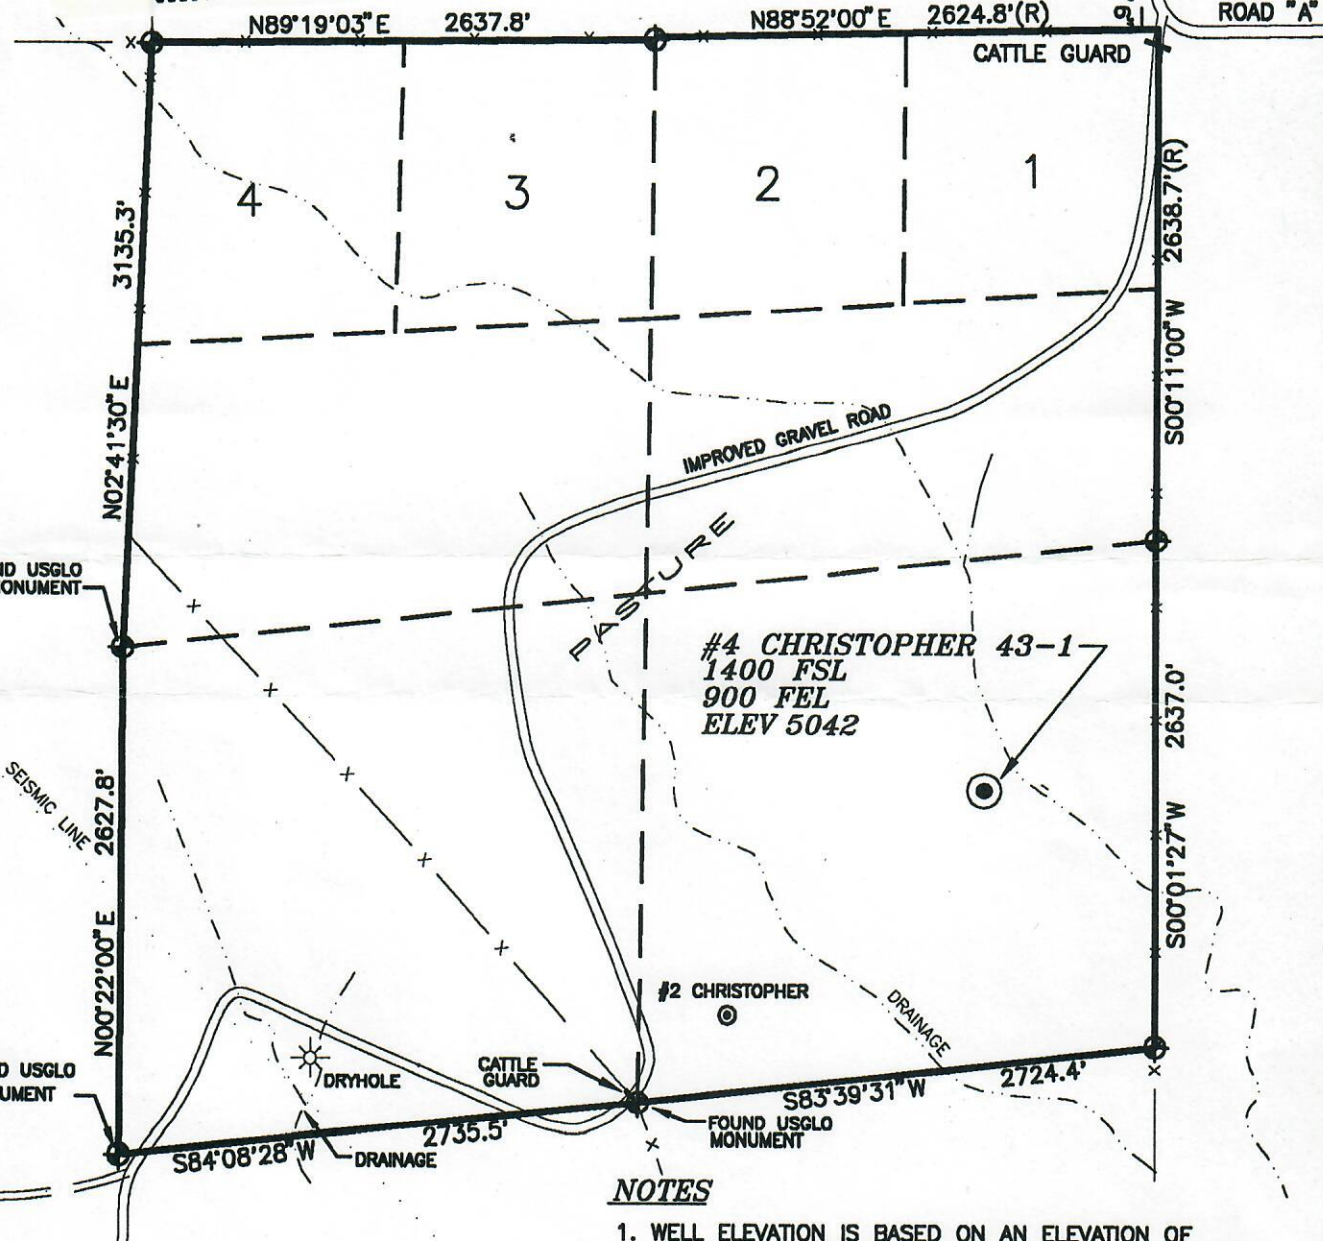

00514467



LEGEND

- ⊕ = FOUND USGLO MONUMENT
- == = IMPROVED ROAD
- === TRAIL
- (R) = RECORD USGLO INFORMATION

NOTES


1. WELL ELEVATION IS BASED ON AN ELEVATION OF 5045 AT THE SW CORNER OF SECTION 1.
2. ALL DIMENSIONS AND SECTION LINES SHOWN HEREON ARE BASED ON FIELD MEASUREMENTS OF EXISTING MONUMENTS AND/OR PHYSICAL EVIDENCE FOUND IN THE FIELD, UNLESS OTHERWISE INDICATED.
3. PHYSICAL FEATURES SHOWN HEREON ARE FOR GRAPHICAL REPRESENTATION ONLY.
4. THIS IS NOT A LAND SURVEY OR LAND SURVEY PLAT.

1000 0 1000 2000

GRAPHIC SCALE IN FEET

JOB	7121_3
DATE	5/15/93
SURV	EJG/AWL
FB	TDS
DRAWN	DCC
CHK	DCC/EJG
DWG. #	7121_3

revised 5/19/93

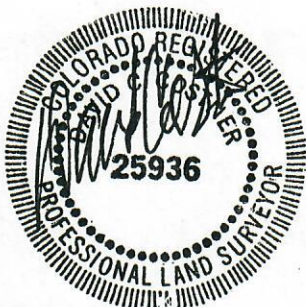

P.O. BOX 194
LAFAYETTE
COLO - 80026
303-666-0379

WELL LOCATION MAP
PREPARED FOR

UNION PACIFIC RESOURCES

#4 CHRISTOPHER 43-1
SE 1/4 SECTION 1 T12S R51W 6PM
CHEYENNE COUNTY, COLORADO