WELLBORE SCHEMATIC

Current

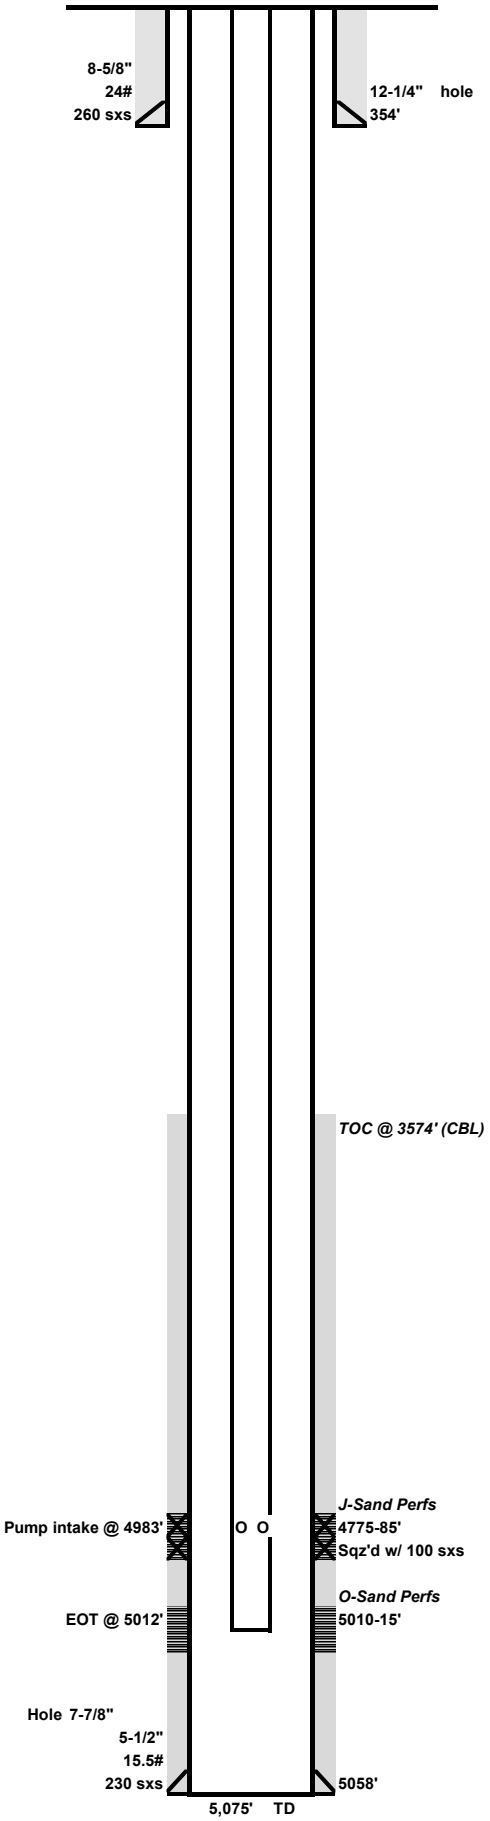

Lease:	**Dubois**			Well No.	**Dubois 5**
API No.				Status	
Location:	2220' FWL & 330' FNL Sec. 7, T9N-R52W				
County:	Logan	State:	CO	Field:	Padroni
TD	5075'	GL	4036'	Spud Date:	4/24/2000
PBTD	5042'	KB	4048'	Comp Date:	5/27/2000
Current Perfs/OH:	5010-15'	Current Zone:	O-Sand		

Surface Equipment

Unit Make:		Unit Size:	
Unit S/N:		Unit Rotation:	
SPM:	Stroke Length:	Unit Sheave:	
Prime Mover:		Motor Sheave:	
Motor S/N:		Motor RPM:	

Casing Breakdown

	Size	Grade / Wt	Depth	Hole Size	Cement
Surface	8-5/8"	24#	354'	12-1/4"	260 sxs
Production	5-1/2"	15.5#	5058'	7-7/8"	230 sxs
Production					
Production					
Liner					

Tubing Breakdown

Qty	Description	Footage
156	2-7/8" tbg	4938.00'
1	Ck/d	1.00'
2	PMP	42.60'
1	Intake	1.00'
2	Seal	11.40'
1	Motor	18.40'
	TOTAL	**5012.40'**

Rod Breakdown

Qty	Description	Footage
	TOTAL	**0.00'**

Comments

PREPARED BY:	LL	UPDATED:	3/3/2022