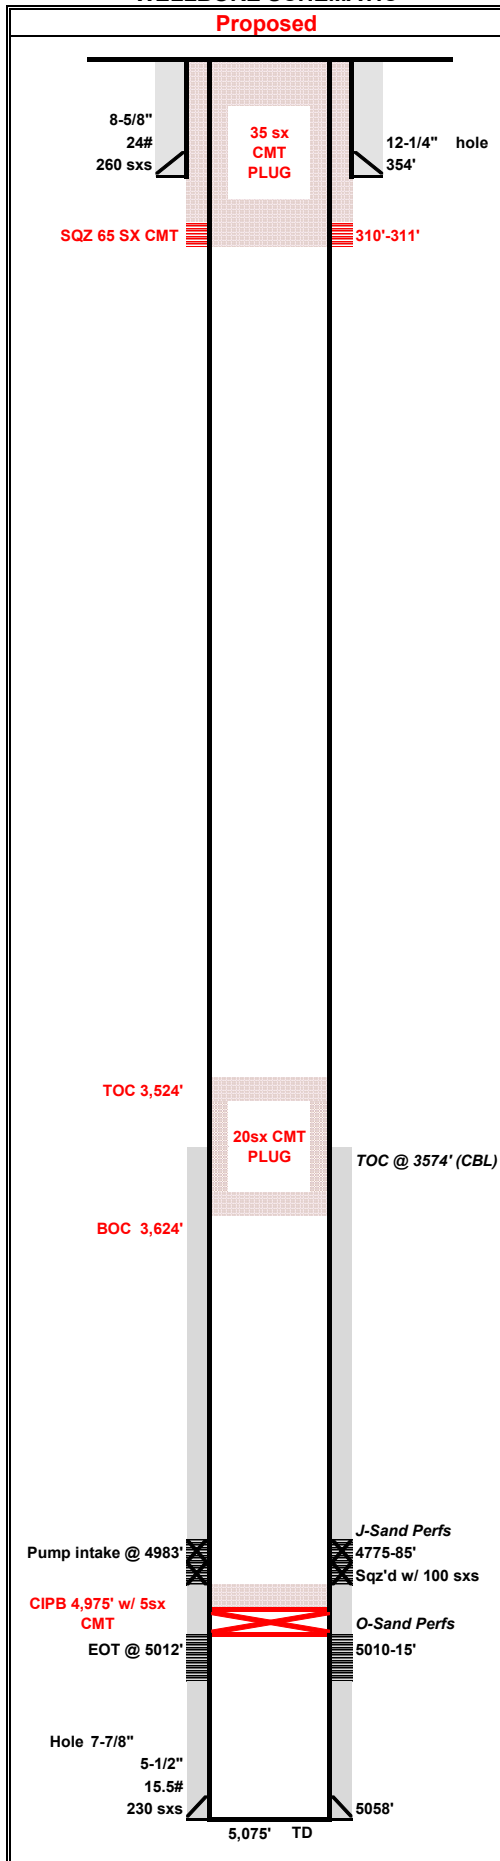


WELLBORE SCHEMATIC

[illegible]