


Yeltsin #1

Location: SWSE 1 15S45W 6
 Field: Ladder Creek
 Footages: 38.770777 / -102.395106
 Elevation: 4,304'

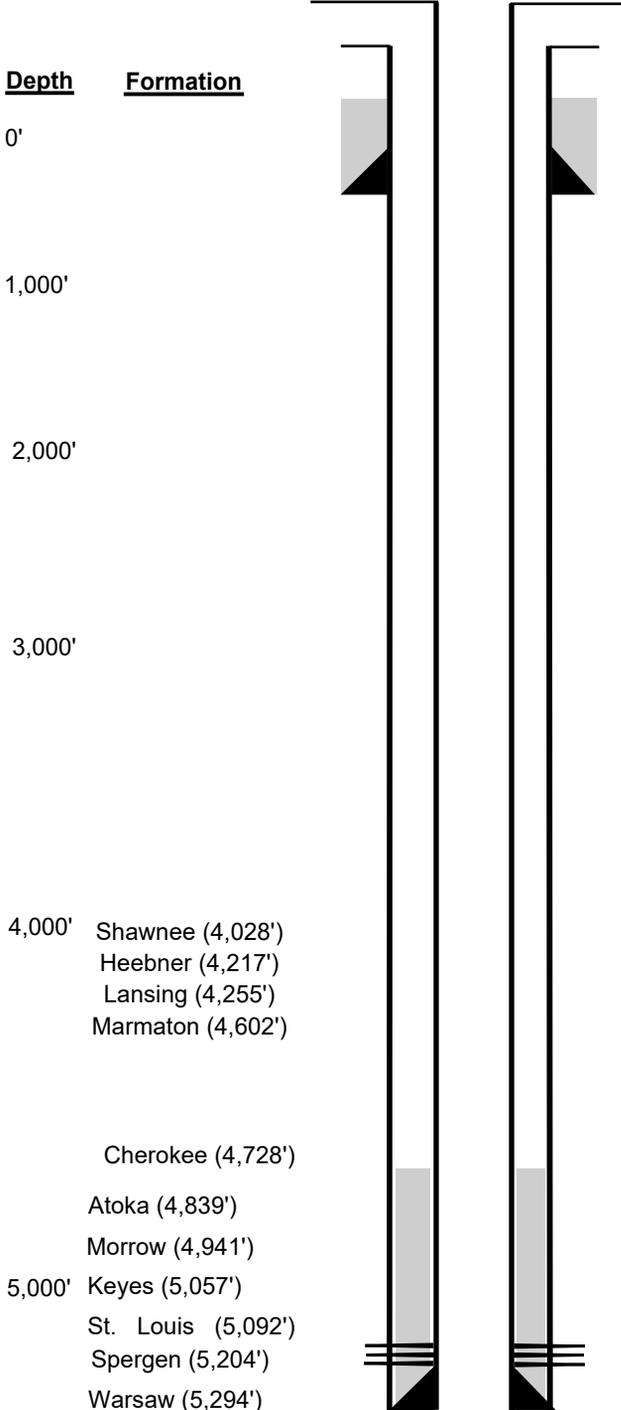

Existing Casing and Cement Coverage

Surface Hole Size: 17.25"
 Top: 0'
 Depth: 412'
 Weight: 54 ppf
 Cement Sacks: 275
 Casing Hole: 13.375"

Deepest water well within 1 mile=375

1st String Hole Size: 8.75"
 Top: 4,850' (calc) Depth: 5,362' Weight: 15.5 ppf
 Cement Sacks: 175 Casing Hole: 5.5"

Mississippian-Spergen perms 5,226'-5,286' 3/4/92