


Republican #12-1

Location: SWNE 12 15S45W 6
Field: Ladder Creek
Footages: 38.763864 / -102.394752
Elevation: 4,283'

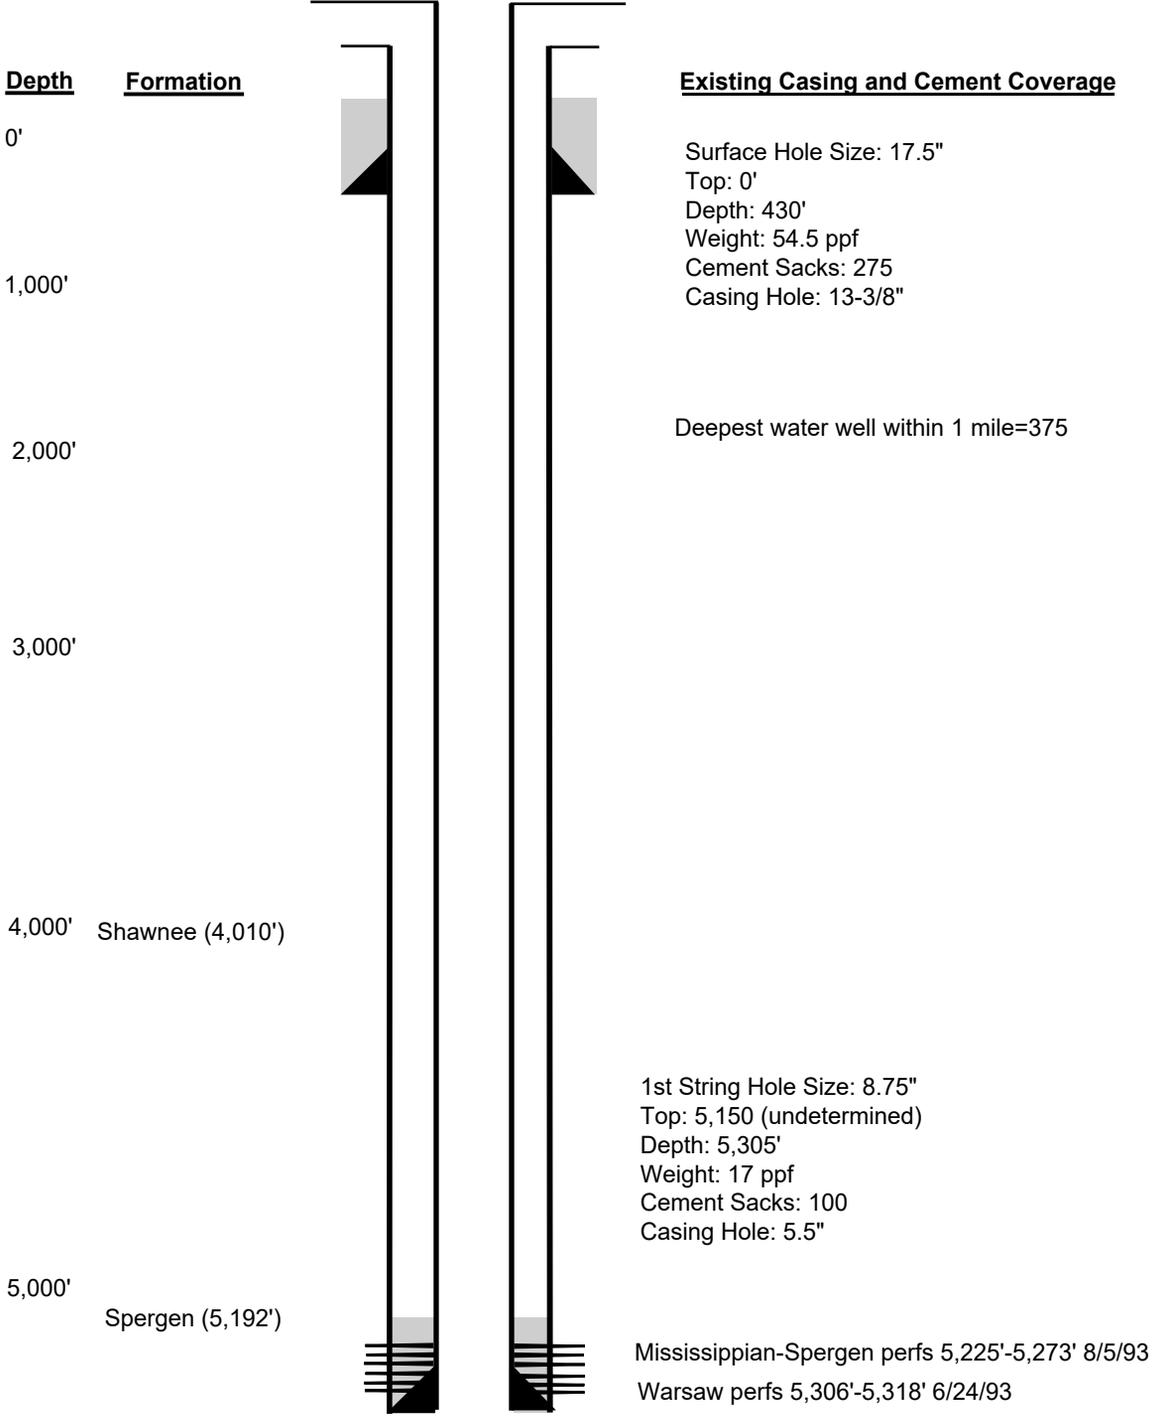

TD 5,305' MD