


WELLBORE DIAGRAM
 COWAN OIL CO
 BLAZER K-5 #5
 SWSE SEC 35 7N 66W
 WELD COUNTY
 05-123-12177

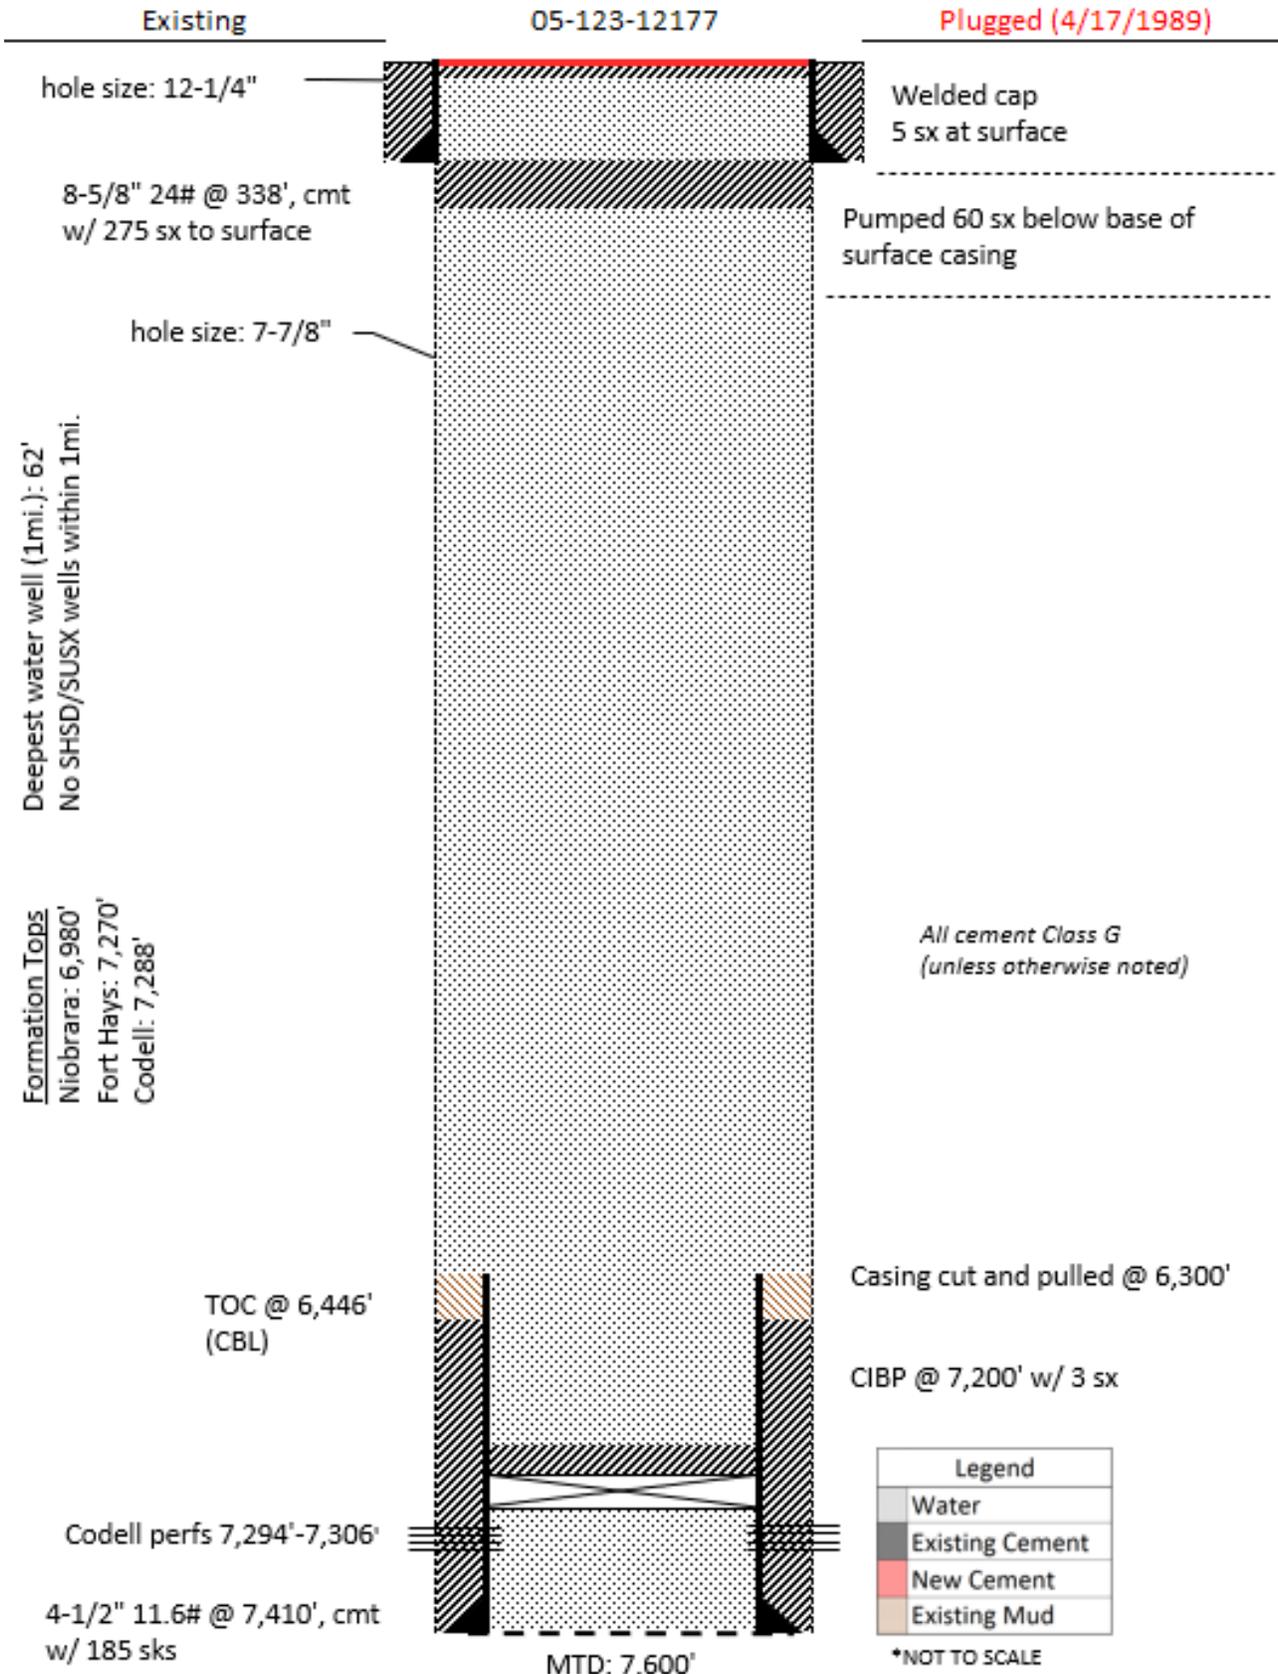

Legend	
[White Box]	Water
[Grey Box]	Existing Cement
[Red Box]	New Cement
[Brown Box]	Existing Mud

*NOT TO SCALE