


Well Name: SADIE CC31-12

VERTICAL, ORIGINAL HOLE, 3/21/2022 2:33:12 PM

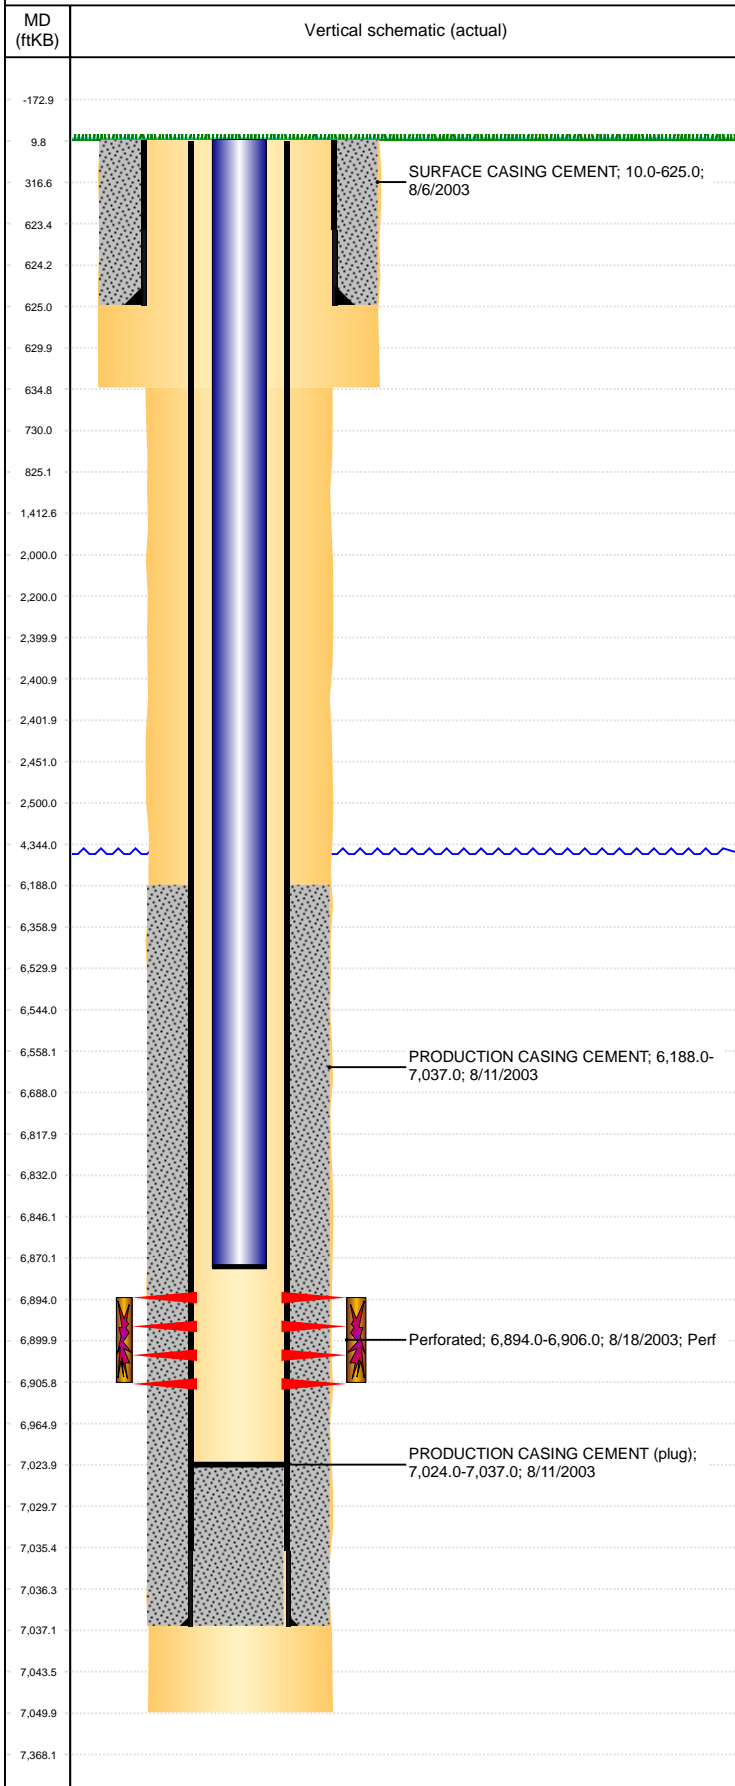

Well Header									
API 05-123-21394		Business Unit DJ BASIN			District 15		Well Config VERTICAL		
KB - GL / MSL (ft... 10.00		Spud Date 8/6/2003		P & A Date		Well Production Status PR		SoRT No	
Comment									
Surface Location (Congressional)									
Qtr 3 NW	Qtr 4 SW	Section 31	Twnshp 4	Twnsh... N	Range 63	Rng E/... W	Actual Latitude (°) 40.26693704	Actual Longitude (°) -104.48688080	
Wellbore Sections									
Section Des			Size (in)			Act Top, MD (ftKB)		Act Btm, MD (ftKB)	
SURFACE			12 1/4			10		635	
PRODUCTION			7 7/8			635		7,050	
Casing Strings									
Csg Des			Run Date		OD (in)	Wt/Len (lb/ft)	Grade	Top, MD (ftKB)	MD (ftKB)
Surface Casing			8/6/2003		8 5/8	24.00	J-55	10.0	625.0
Production			8/11/2003		4 1/2	11.60	M-80	10.0	7,037.0
Cement									
Des					Start Date		Top (ftKB)		Btm (ftKB)
SURFACE CASING CEMENT					8/6/2003		10.0		625.0
PRODUCTION CASING CEMENT					8/11/2003		6,188.0		7,037.0
Zone Statuses									
Zone Name		Status Date	Status	Fluid Type	Job			Prod Method	
CODELL		8/29/2003	PR		DRILLING/COMPLETION - ORIGINAL, 8/6/2003...				
Perforation Data									
Linked Zone			Bnch/Stg	Entered Shot Total	Top (ftKB)		Btm (ftKB)		Date
CODELL, ORIGINAL HOLE				48	6,894.00		6,906.00		8/18/2003
Stimulation Intervals									
Zone					Start Date		Top (ftKB)		Btm (ftKB)
CODELL, ORIGINAL HOLE					8/27/2003		6,894.0		6,906.0
Other In Hole									
Run Date		Des			Make		OD (in)	Top (ftKB)	Btm (ftKB)
Logs									
Date		Type					Top, MD (ftKB)		Btm, MD (ftKB)
8/11/2003		COMPENSATED DENSITY					4,000.0		7,030.0
8/11/2003		INDUCTION					630.0		7,050.0
8/18/2003		CBL/CCL/GR					6,080.0		7,022.0
Plug Back Total Depths									
Date		Type			Com				Depth (ftKB)
8/11/2003		LATCH DOWN COLLAR			LATCH DOWN COLLAR				7,022.0
8/18/2003		FILL			DEPTH LOGGER				7,024.0