


Well Completion Diagram


API Well No:		05-043-40031-00-	
Owner:	BELTRAMO JR* ALEX	Well Name:	C.F.&I.
County:	FREMONT	Field:	FLORENCE-CANON CITY
Pool:			
Coordinates: X	169 FWL	Y	1027 FSL
Sec:	18	Twp:	19S
Rng:	69W		

Note: Changes to the drawing do not effect the database

Bore Diameters (in.)

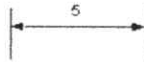

Cement Top: 0' mthd: U

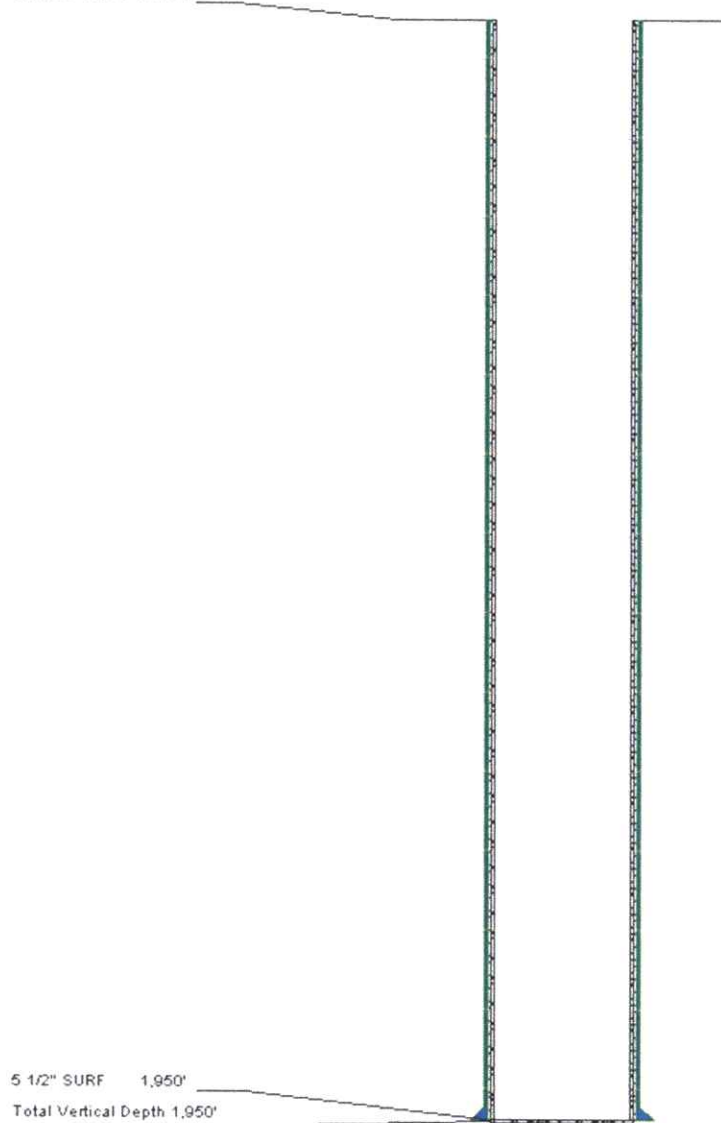

5 1/2" SURF 1,950'

Total Vertical Depth 1,950'