



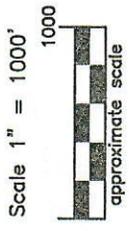

123-30009

WELL LOCATION CERTIFICATE

THIS MAP DOES NOT REPRESENT A BOUNDARY SURVEY

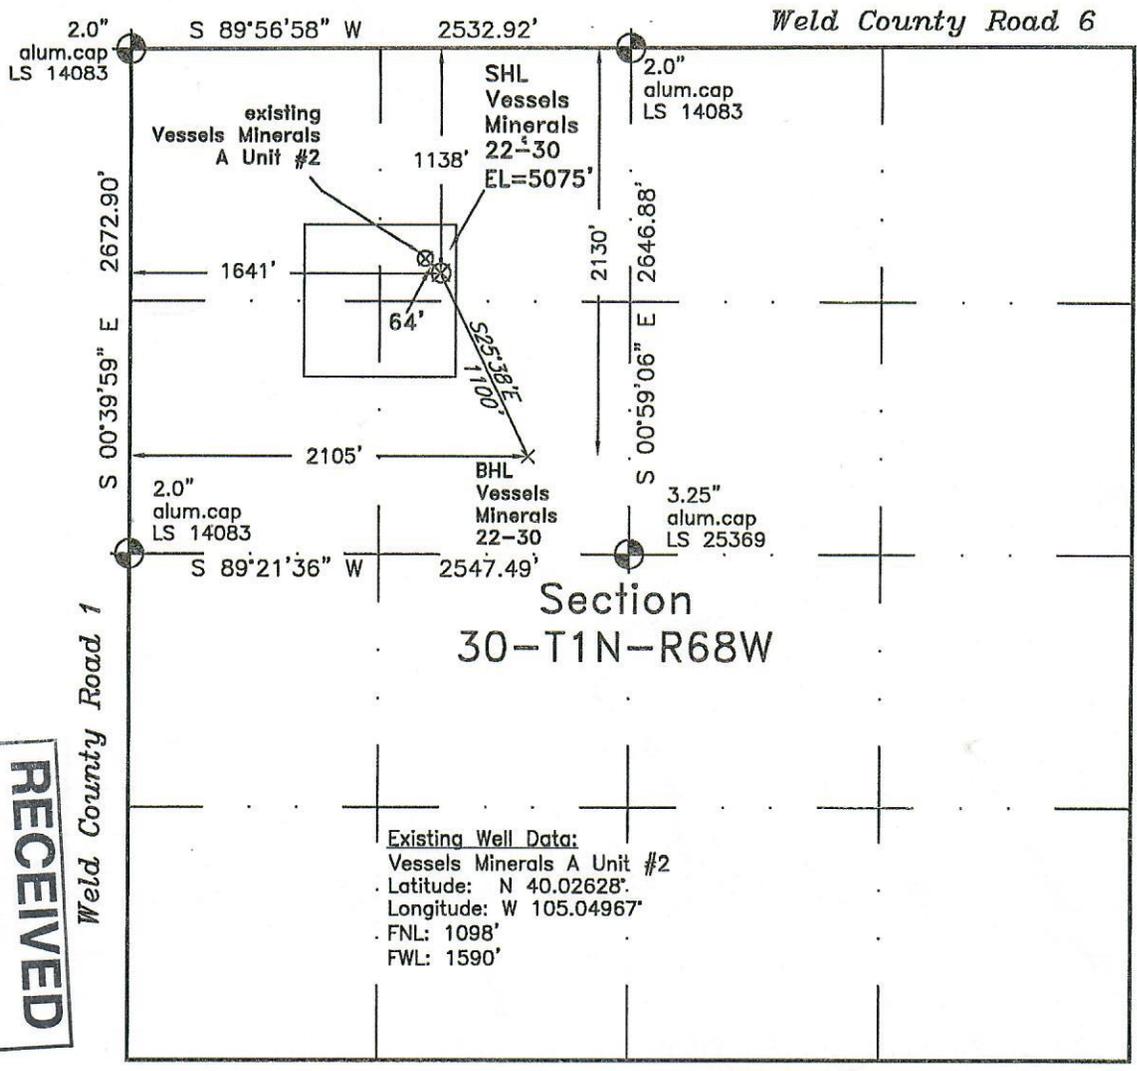

RECEIVED
SEP 02 2010
COGCC

Existing Well Data:
Vessels Minerals A Unit #2
Latitude: N 40.02628°
Longitude: W 105.04967°
FNL: 1098'
FWL: 1590'

Commander Drive

In accordance with a request from Cynthia Owens of EnCana Oil & Gas (USA) Inc., Frederick Land Surveying, Inc. has determined the location of the **VESELS MINERALS 22-30** well site to be SHL: 1138' FNL and 1641' FWL, (BHL 2130' FNL and 2105' FWL) as measured at ninety (90) degrees from the section lines of Section 30, Township 1 North, Range 68 West of the 6th Principal Meridian, Town of Erie, Weld County, Colorado.

Proposed Surface Hole Data:
Latitude: N 40.02617° BHL(40.02344°)
Longitude: W 105.04949° BHL(105.04780°)
Nearest: Building 1336' northwest Above Ground Utility 1164' northwest
Public Road 1115' north Railroad (abandoned) 899' west
Property Line 323' east
PDOP: 2.4

I hereby certify that this Well Location Certificate was prepared by me or under my direct supervision on 9/27/10 for and on behalf of EnCana Oil & Gas (USA) Inc. and that it is a Land Survey Plat or an Improvement Survey Plat and that it is not to be relied upon for establishment of fences, buildings, or other future improvement lines.

Alex Rondon Perkins LS#34176
Job #: 08119.042 6-2-2010

- Notes:
- 1) Bearings and distances based on NAD 83 Colorado North State Plane Coordinates using RTK GPS observations taken 5/26/10 by operator Craig Burke.
 - 2) Conversion factor to ground (1.000279397).
 - 3) Elevations based on NAVD 88 GPS heights and Geoid 2003 corrections.
 - 4) See improvement map for visible improvements within 400 feet of pad site.
 - 5) The location falls on non-crop (residential) land.

NOTICE: According to Colorado law you MUST commence any legal action based upon any defect in this W.L.C. within 3 years after you first discover such defect. In no event may any action based upon any defect in this W.L.C. be commenced more than 10 years from this said date of the certification shown hereon.