


Well Completion Diagram

API Well No: 05-043-40024-00-							
Owner: JAVERNICK OIL COMPANY		Well Name: ROB HIAWATHA					
County: FREMONT		Field: FLORENCE-CANON CITY		Pool:			
Coordinates: X 902 FEL		; Y 1738 FNL		Sec: 8	Twp: 20S		Rng: 69W

Note: Changes to the drawing do not effect the database

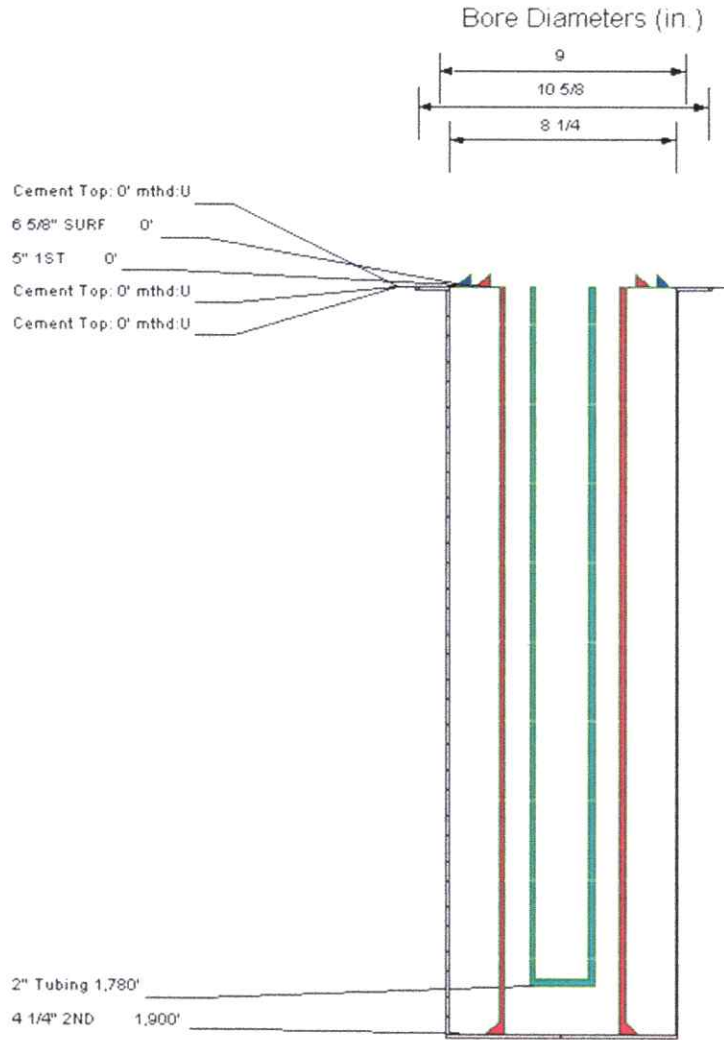

Total Vertical Depth 2,800'