


Well: Alcorn #32-10
API: 05-013-06579
Operator Crestone Peak Resources Operating LLC
County Boulder
State Colorado
Field Wattenberg
Location: NWNE 10 1N 69W
SHL: 1095' FNL 1585' FEL
BHL: 2095' FNL 2020' FEL
Elevation: 5083' GR 5096' KB
Spud Date: 11/24/2008
TD Date: 12/01/2008

Log Tops

Sussex	4585'
Shannon	5060'
Niobrara	7456'
Codell	7832'
J Sand	8249'

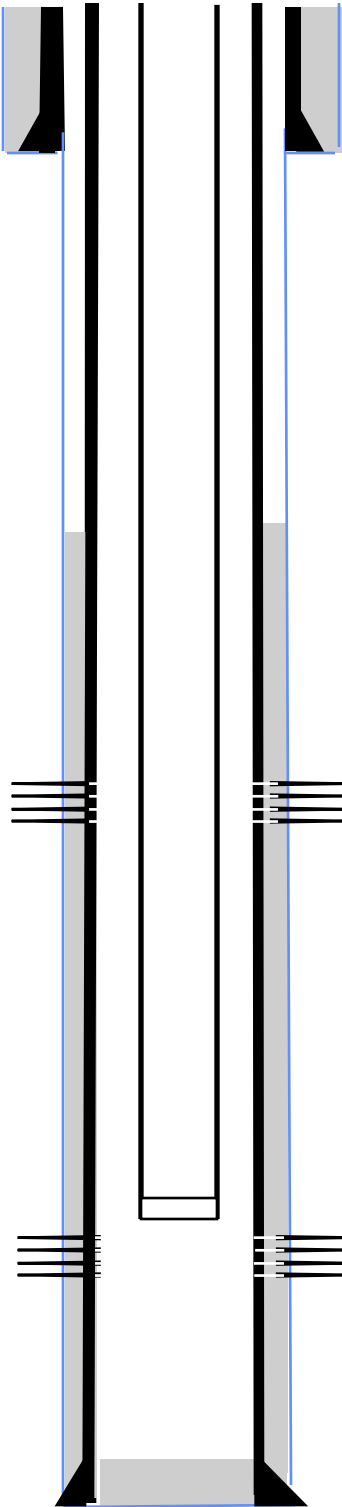

Surface Casing and Cement

Casing size: 8 5/8", Hole Size: 12 1/4", landed @ 951', cemented with 430 sxs
TOC @ Surface

Main Hole

7-7/8" to TD

Production Casing and Cement

Casing size: 4-1/2", Hole size: 7 7/8", landed @ 8414', cemented with 280 sxs
TOC @ 6980'

Perf'd the Niobrara-Codell (commingled) from 7456'-7852' (88 holes). Frac'd CODL w/ 109284 gal 24# Vistar hybrid cross linked gel containing 250,440# sand. Frac'd NBRR w/ 118944 gal 18# vistar hybrid cross linked gel w/ 250260# sand

Production Tubing

2-3/8" tubing, set @ 8238'

Perf'd the J Sand from 8262' - 8278' (32 holes) w/ 150276 gal 20# vistar hybrid cross linked gel containing 250960# sand

8430' — Driller's TD