


Well: Anderson Trust C #1
API: 05-123-11882
Operator: Crestone Peak Resources Operating LLC
County: Weld
State: Colorado
Field: Wattenberg
Location: NENE 32 2N 68W
SHL: 990' FNL 1040' FEL
Elevation: 4946' GR 4956' KB
Spud Date: 07/10/1984
TD Date: 07/19/1984

Log Tops

Sussex	4330'
Shannon	4868'
Niobrara	7280'
Timpas	7525'
Codell	7546'
Greenhorn	7610'
J Sand	7974'

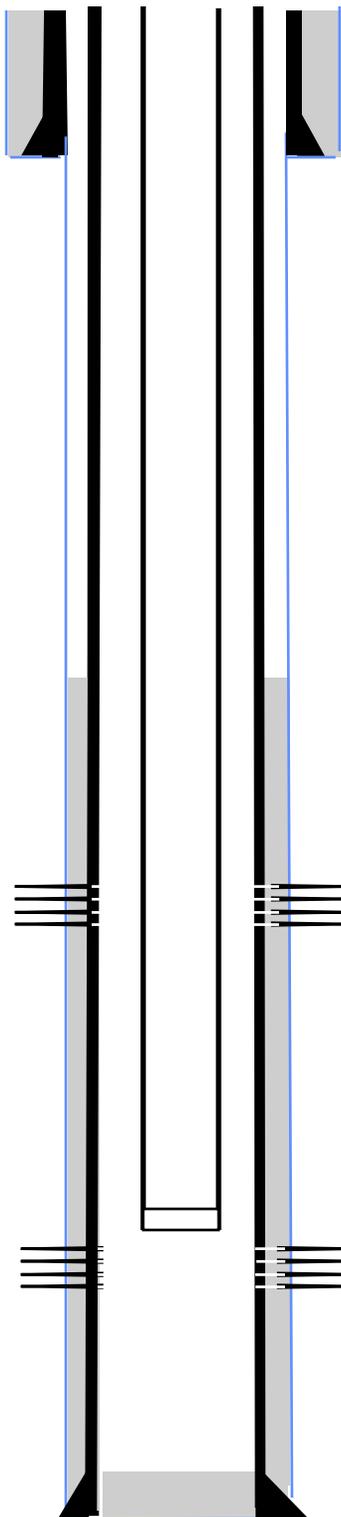

Surface Casing and Cement

Casing size: 8 5/8", Hole Size: 12 1/4", Weight: 24#, landed @ 725', cemented with 450 sx TOC @ Surface

Main Hole

7-7/8" to TD

Production Casing and Cement

Casing size: 4-1/2", Hole size: 7 7/8", Weight: 11.6#, landed @ 8150', cemented with 400 sx TOC @ 6590'
 Additional Cement: From 338' - 1020', 150 sx

Perf'd the Codell from 7548' - 7567' (76 holes) w/ 300000# 20-40 sand; 85134 gal gel

Perf'd the J Sand from 7976' - 8002' (84 holes) w/ 1000 gals 7.5% HCL fluid. Frac'd w/ 115000 gals 50# gel & 325000# 20-40 sand. Flushed w/ 5700 gals 2% KCL water

Production Tubing
 2-3/8" tubing, set @ 7943'

8150' — Driller's TD