


Wellbore Schematic Input Report-DJ

Well Name: HUNGENBERG E21-25

VERTICAL, ORIGINAL HOLE, 4/20/2022 12:14:26 PM

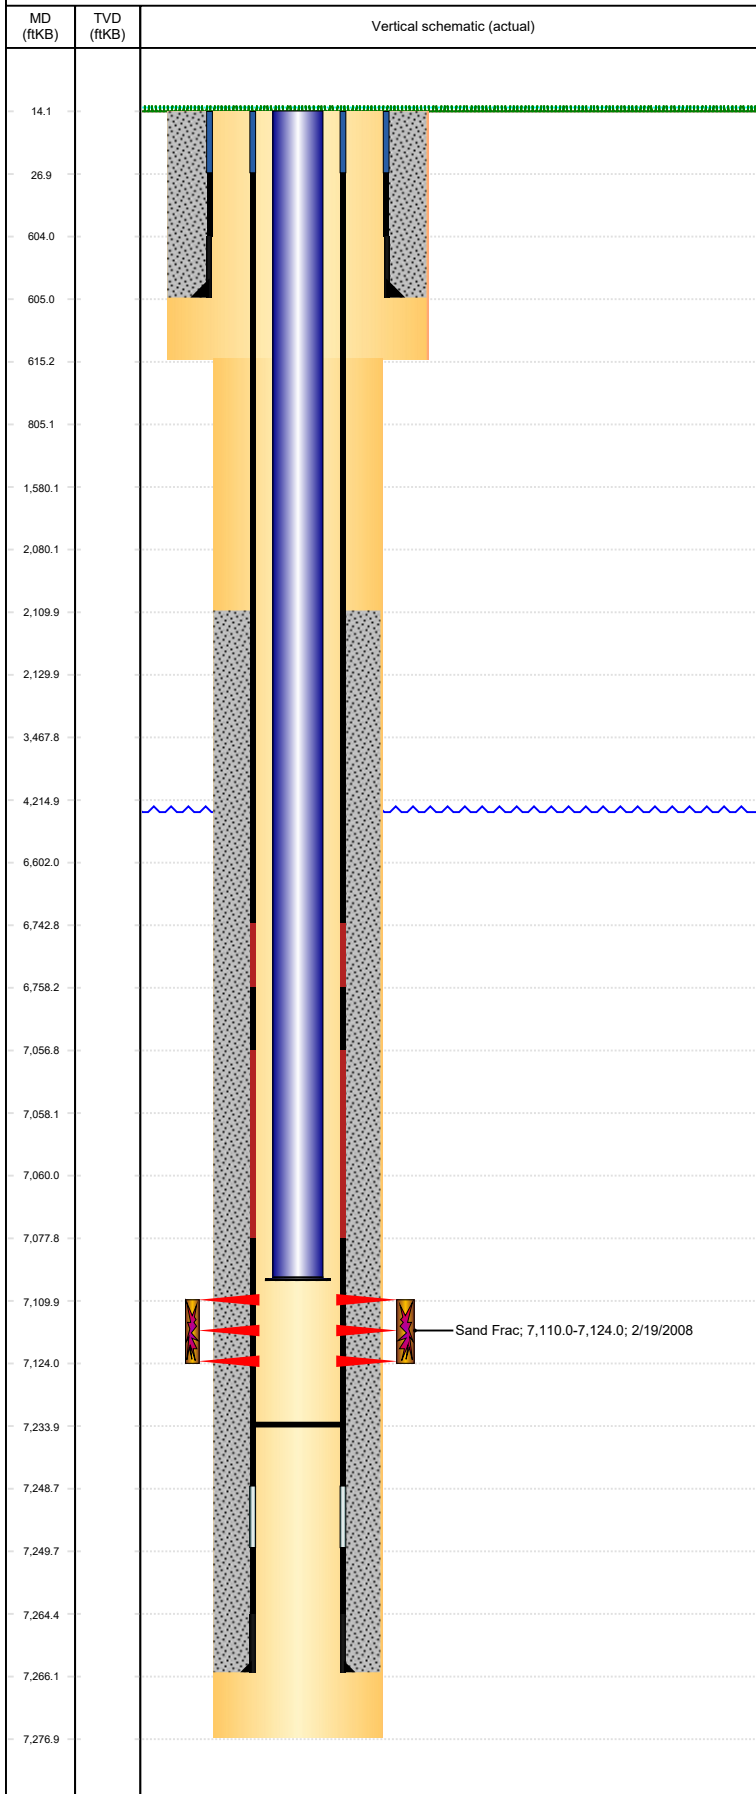

Well Header						
API 05-123-26556	Business Unit DJ BASIN		District 15	Well Config VERTICAL		
Original KB Elevation (ft) 4,745	KB - GL / MSL (ftKB) 14.00		Spud Date 1/13/2008		P & A Date	
Comment						
Directions To Well WCR 41 & WCR 66, E 0.1, N 0.2, E 0.1 INTO LOCATION						
Congressional Location						
Quarter 3 NW	Quarter 4 SW	Section 21	Township 6	Twnshp N/S Dir N	Range 65	Range E/W Dir W
Bottom Hole Legal Location						
Bottom Hole Legal Location						
Plug Back Total Depths						
Date	Depth (ftKB)	Method		Com		
1/16/2008	7,250.0	CASING TALLY		TOP OF FLOAT COLLAR		
2/4/2008	7,234.0	CASED HOLE LOG		CBL DEPTH LOGGER		
Wellbore Sections						
Section Des		Size (in)		Act Top, MD (ftKB)		Act Btm, MD (ftKB)
SURFACE		12 1/4		14		615
PRODUCTION		7 7/8		615		7,277
Zone Statuses						
Zone Name	Status Date	Status	Fluid Type	Job	Prod Method	
CODELL	2/20/2008	PR	Gas	DRILLING/CO...		
Casing Strings						
Surface, 605.0ftKB						
Casing Description Surface	Run Date 1/13/2008	OD (in) 8 5/8	Wt/Len (l... 24.00	Grade J-55	Top, MD (ft... 14.0	MD (ftKB) 605.0
Production, 7,266.0ftKB						
Casing Description Production	Run Date 1/16/2008	OD (in) 4 1/2	Wt/Len (l... 11.60	Grade M-80	Top, MD (ft... 14.0	MD (ftKB) 7,266.0
Cement						
Description SURFACE CASING CEMENT				Top Depth (ftKB) 14.0		Bottom Depth (ftKB) 605.0
Description PRODUCTION CASING CEMENT				Top Depth (ftKB) 2,110.0		Bottom Depth (ftKB) 7,266.0
Tubing Strings						
Tubing Description Tubing - Production	Run Date 2/5/2008	String... 2 3/8	ID (in) 1.87	Wt (lb/ft) 4.70	Grade C-90	Len (ft) 7,085.00
Set De...						
Tubing Components						
Item Des	OD (in)	Wt (lb/ft)	Grade	Jts	Len (ft)	Btm (ftKB)
Tubing	2 3/8	4.70	C-90	230	7,083.60	7,097.6
Pump Seating	2 3/8			1	1.10	7,098.7
Nipple						
Notched collar	3			1	0.30	7,099.0
	1/16					
Other In Hole						
Run Date	Des		Make	OD (in)	Top (ftKB)	Btm (ftKB)
Logs						
Date	Type			Top, MD (ftKB)	Btm, MD (ftKB)	
1/16/2008	Caliper/Comp.Density/Neutron/GR/SP /ML			2,650.0	7,255.0	
1/16/2008	DIL/GR/SP/Caliper			605.0	7,275.0	
2/4/2008	CBL/CCL/GR			1,960.0	7,234.0	
10/24/2018	GYRO			14.0	7,000.0	
Perforation Data						
Linked Zone	Bnch/St g	Sum of Entered Shot Total	Top (ftKB)	Btm (ftKB)	Date	
CODELL, ORIGINAL HOLE		56	7,110.00	7,124.00	2/5/2008	
Total		56				

Well Name: HUNGENBERG E21-25

VERTICAL, ORIGINAL HOLE, 4/20/2022 12:14:26 PM

Stimulation Intervals

Interval...	Start Date	Primary Job Type	Zone
1	2/19/2008	DRILLING/COMPLETION - ORIGINAL	CODELL, ORIGINAL HOLE
Technical Result		Tech Result Details	Tech Result Note
Success		According to Plan	
Comment			
(CODELL) TREATMENT WENT WELL			

