


**Well Name: BELL USX Y29-03**

VERTICAL, ORIGINAL HOLE, 5/5/2022 12:38:20 PM

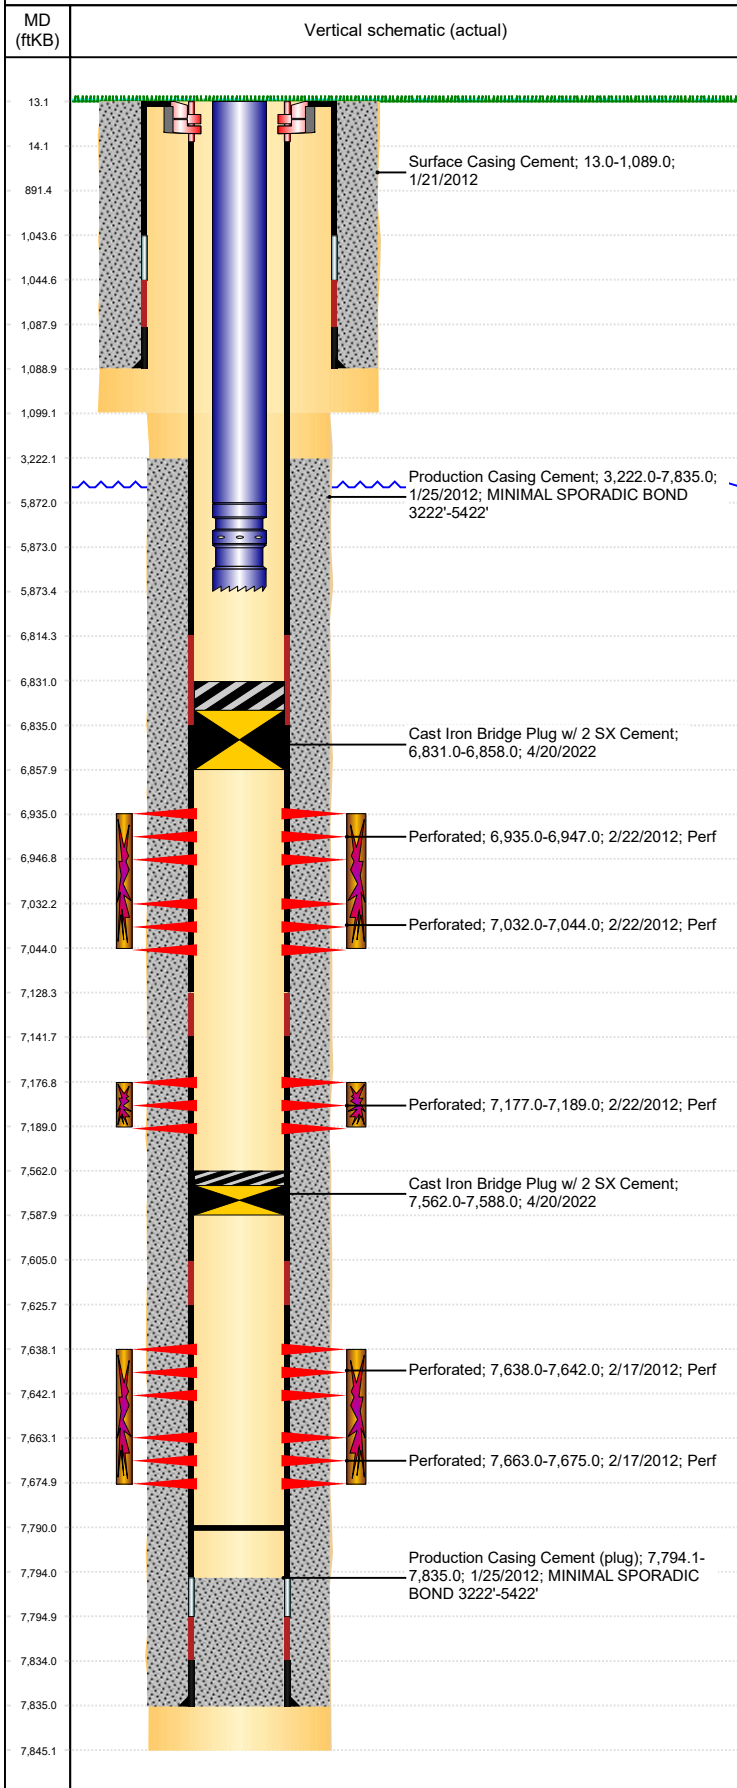

Well Header					
API 05-123-32604		Business Unit DJ BASIN		District 15	Well Config VERTICAL
KB - GL / MSL (ft... 13.00	Spud Date 1/20/2012	P & A Date	Well Production Status TA		SoRT Yes
Comment					

## Surface Location (Congressional)

Qtr 3	Qtr 4	Section	Twonsh...	Twonsh...	Range	Rng E/...	Actual Latitude (°)	Actual Longitude (°)
NE	NW	29	2	N	64	W	40.11532011	-104.57683589

## Wellbore Sections

Section Des	Size (in)	Act Top, MD (ftKB)	Act Btm, MD (ftKB)
SURFACE	12 1/4	13	1,099
PRODUCTION	7 7/8	1099	7,845

## Casing Strings

Csg Des	Run Date	OD (in)	Wt/Len (lb/ft)	Grade	Top, MD (ftKB)	MD (ftKB)
Surface	1/21/2012	8 5/8	24.00	J-55	13.0	1,089.0
PRODUCTION	1/25/2012	4 1/2	11.60	M-80	13.0	7,835.0

## Cement

Des	Start Date	Top (ftKB)	Btm (ftKB)
Surface Casing Cement	1/21/2012	13.0	1,089.0
Production Casing Cement	1/25/2012	3,222.0	7,835.0

## Zone Statuses

Zone Name	Status Date	Status	Fluid Type	Job	Prod Method
NIOBRARA	3/16/2012	PR		DRILLING/COMPLETION - ORIGINAL, 1/19/2012...	
CODELL	3/16/2012	PR		DRILLING/COMPLETION - ORIGINAL, 1/19/2012...	
J SAND	3/16/2012	PR		DRILLING/COMPLETION - ORIGINAL, 1/19/2012...	

## Perforation Data

Linked Zone	Bnch/Stg	Entered Shot Total	Top (ftKB)	Btm (ftKB)	Date
NIOBRARA, ORIGINAL HOLE	B	24	6,935.00	6,947.00	2/22/2012
NIOBRARA, ORIGINAL HOLE	C	24	7,032.00	7,044.00	2/22/2012
CODELL, ORIGINAL HOLE		48	7,177.00	7,189.00	2/22/2012
J SAND, ORIGINAL HOLE		16	7,638.00	7,642.00	2/17/2012
J SAND, ORIGINAL HOLE		48	7,663.00	7,675.00	2/17/2012

## Stimulation Intervals

Zone	Start Date	Top (ftKB)	Btm (ftKB)
NIOBRARA, ORIGINAL HOLE	2/22/2012	6,935.0	7,044.0
CODELL, ORIGINAL HOLE	2/22/2012	7,177.0	7,189.0
J SAND, ORIGINAL HOLE	2/22/2012	7,638.0	7,675.0

## Other In Hole

Run Date	Des	Make	OD (in)	Top (ftKB)	Btm (ftKB)
4/20/2022	Cast Iron Bridge Plug w/ 2 SX Cement		3.99	7,562.0	7,588.0
4/20/2022	Cast Iron Bridge Plug w/ 2 SX Cement		3.99	6,831.0	6,858.0

## Logs

Date	Type	Top, MD (ftKB)	Btm, MD (ftKB)
1/24/2012	SPECTRAL DENSITY/Pe/DSN NEUTRON/SP/ARRAY COMPENSATED TRUE RESISTIVITY/SONIC (BSAT)	1,090.0	7,843.0
1/24/2012	SPECTRAL GAMMA RAY	6,663.0	7,788.0
2/14/2012	CBL/CCL/GR	1,900.0	7,794.0
6/15/2017	GYRO	0.0	7,550.0

## Plug Back Total Depths

Date	Type	Com	Depth (ftKB)
2/14/2012	FILL	DEPTH LOGGER ON CBL	7,795.0
2/25/2012	FILL	DRILLED OUT KILLPLUG AND 2-CFP AND C/O TO 7789.91' K...	7,789.9