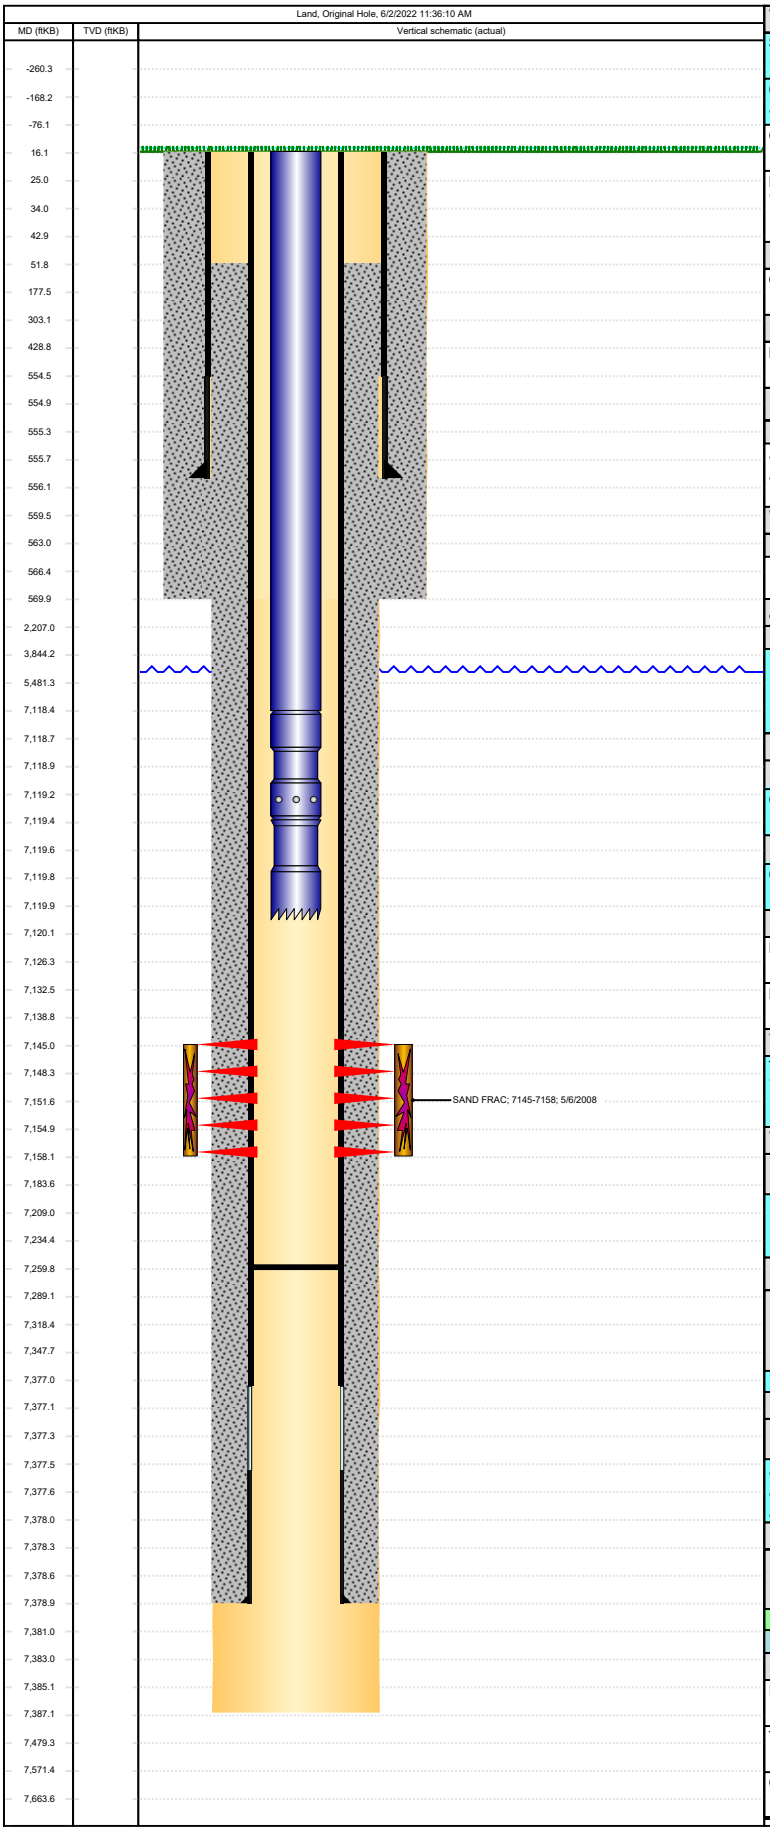

Well Header

Surface UWI	Business Unit	Gov Auth Dist	Prod Tree Loc
0512325308	Rockies		Land

Original RKB Elevation (ft)	Original KB to Ground (ft)	Original Spud Date	Abandon Date
4,810.00	16.00	4/5/2008	

Comment
DISCREPANCY: DR RPT TD 7387'; ST RPT TD 7328'; PROD CSG @ 7379'

Directions To Well
WCR 43 & WCR 76, EAST 1/10, SOUTH ON EAST SIDE OF DITCH 2/10, EAST INTO.

Congressional Location

Quarter 3	Quarter 4	Section	Township	Twnshp N/S Dir	Range	Range E/W Dir
NW	NW	34	7	N	65	W

Bottom Hole Legal Location

Bottom Hole Legal Location

Plug Back Total Depths

Date	PBTD (ftKB)	Method	Com
4/10/2008	7,363	CASING TALLY	FLOAT SHOE W/ BAFFLE
4/30/2008	7,339	CASED HOLE LOG	DEPTH LOGGER ON CBL
5/28/2008	7,260	TAG	CLEAN OUT TO LAND TUBING

Wellbore Sections

Section Des	Hole Size (in)	Act Top (ftKB)	Act Btm (ftKB)
SURFACE	12 1/4	16.0	570.0
PRODUCTION	7 7/8	570.0	7,387.0

Zone Statuses

Zone Name	Status Date	Status	Fluid Type	Job	Prod Method
CODELL	5/12/2008	PR		DRILLING/CO...	
CODELL	5/12/2008	PR	Oil		Flowing
CODELL	2/27/2012	PR	Water		Flowing
CODELL	3/14/2016	PR			

Casing Strings

Surface, Planned?-N, 556ftKB

Casing Description	Run Date	OD (in)	Wt/Len (l...	Grade	Top Depth...	Set Depth...
Surface	4/5/2008	8 5/8	24.00		16	556

Production Casing, Planned?-N, 7379ftKB

Casing Description	Run Date	OD (in)	Wt/Len (l...	Grade	Top Depth...	Set Depth...
Production Casing	4/10/2008	4 1/2	11.60	M-80	16	7379

Cement

Description	Top Depth (ftKB)	Bottom Depth (ftKB)
SURFACE CASING CEMENT	16.0	556.0
PRODUCTION CASING CEMENT	52.0	7,379.0

Tubing Strings

Tubing Description	Run Date	String...	ID (in)	Wt (lb/ft)	Grade	Len (ft)	Set De...
Tubing	5/28/2008	2 3/8				7,104.00	

Tubing Components

Item Des	OD (in)	Wt (lb/ft)	Grade	Jts	Len (ft)	Btm (ftKB)	Btm (TVD) (ftKB)
EUE 8rd Tubing	2 3/8			230	7,102.40	7,118.4	
Seal Nipple	2 3/8			1	1.00	7,119.4	
Notched collar	2 3/8			1	0.60	7,120.0	

Other In Hole

Run Date	Des	Make	OD (in)	Top (ftKB)	Btm (ftKB)	Planned R

Logs

Date	Type	Depth Top (MD) (ftKB)	Btm (ftKB)
4/9/2008	COMPENSATED DENSITY	3,690	7,367.0
4/9/2008	INDUCTION	560	7,387.0
4/30/2008	CBL/CCL/GR	16	7,337.0

Perforation Data

Linked Zone	Explosive Type	Sum of Entered Shot Total	Top (ftKB)	Btm (ftKB)	Date
CODELL, Original Hole		52	7,145.0	7,158.0	5/3/2008
Total (Sum)		**52**			

Stimulation Intervals

Interval...	Start Date	Primary Job Type	Zone
1	5/6/2008	DRILLING/COMPLETION - ORIGINAL	CODELL, Original Hole

Technical Result	Tech Result Details	Tech Result Note

Comment