BISON OIL & GAS

Final - As Plugged Wellbore Schematic

Well Name:	Alice Nay 1-A	Date Prepared:	3/15/2022
Location:	2208' FNL, 2313' FEL, SWNE Sec 14, T9N, R58W	Last Updated:	6/7/2022
County	Weld	Spud Date:	4/5/1952
API #:	05-123-05662	Completion Start Date:	N/A
Co-ordinates:	40.752661 / -103.829959	Last Workover Date:	N/A
Elevations:	GROUND: 4662'	Prepared by:	Jake Van Bramer
	KB: 4671'	Updated by:	Jake Van Bramer
Depths (KB):	PBTD: --		
	TD: 6277'		

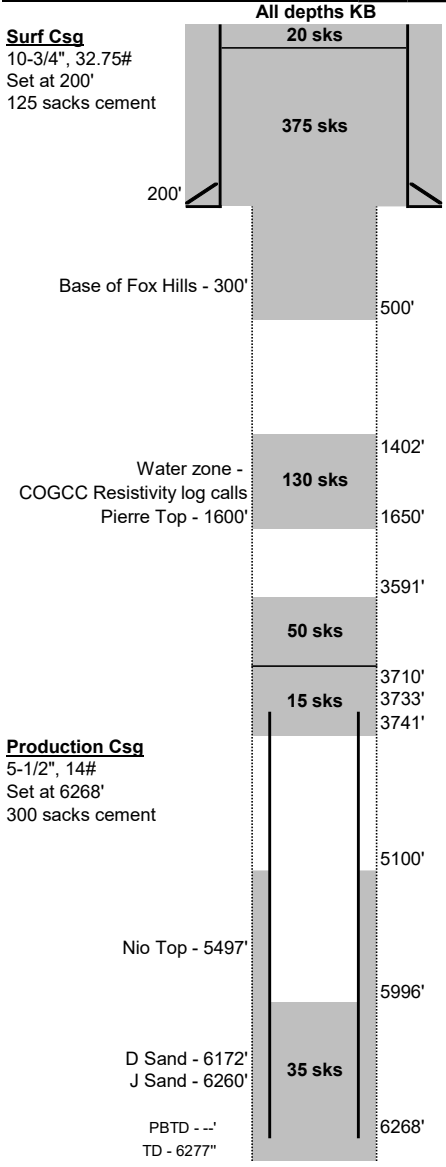

Hole Size	
Unknown	0-200'
Unknown	200-6277'

Surface Casing:
- Unknown Hole Size, assumed to be 15-1/2"
- Landed 10-3/4", 32.75# H-40 casing at 200'
- Cemented with 125 sks

Production Casing:
- Landed 5-1/2", 14# J-55 casing at 6268'
- Cemented with 300 sks (TOC calculated 5100')
- Casing cut and pulled at 3733'

Open Hole:
- 200'-3733', hole size unknown, likely 8-7/8"

Tubing:
- None

Rods:
- None

Perforations:
- None

P&A Plugs:
1. 35 sks from 5996' - 6277' (existing)
2. 15 sks from 3710'-3741' (TOC Tagged)
3. 50 sks Class G (1.15 cuft/sk) from 3591'-3710' (TOC Estimated)
4. 130 sks Class G (1.15 cuft/sk) from 1402' to 1650' (TOC Tagged)
5. 375 sks Class G (1.15 cuft/sk) from 519' to surface
6. 20 sks Top Off

Additional Notes:

Initial Potential Test:

Formation Tops:

Niobrara	5497'
D Sand	6172'
J Sand	6260'

PBTD - --'
TD - 6277"