BISON OIL & GAS

Final - As Plugged Wellbore Schematic

Well Name:	Ingram 1	Date Prepared:	11/30/2021
Location:	660' FNL, 660' FEL, NENE Sec 23, T9N, R58W	Last Updated:	6/1/2022
County	Weld	Spud Date:	2/20/1956
API #:	05-123-05639	Completion Start Date:	N/A
Co-ordinates:	40.742465 / -103.823865	Last Workover Date:	N/A
Elevations:	GROUND: 4651'	Prepared by:	Jake Van Bramer
	KB: 4658'	Updated by:	--
Depths (KB):	PBTD: --		
	TD: 6361'		

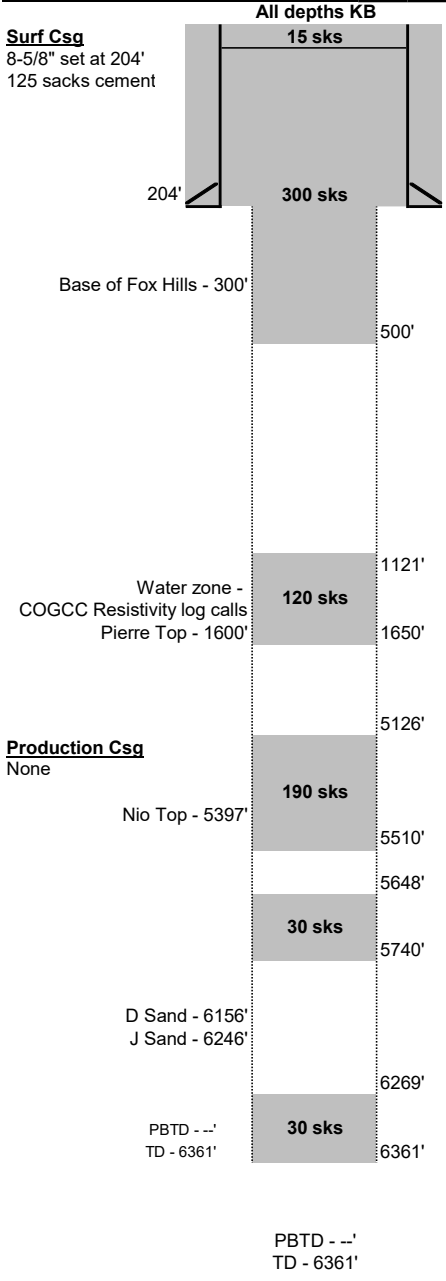

Hole Size
Unknown
0-204'

Unknown
204'-6361'

Surface Casing:
Unknown Hole Size, assumed to be 12.25"
Landed 8-5/8" casing at 204'
Cemented with 125 sks

Production Casing:
No production casing

Open Hole:
204'-6361', hole size unknown, likely 7-7/8"

Tubing:
None

Rods:
None

Perforations:
None

P&A Plugs:
1. 30 sks from 6269'-6361' (existing)
2. 30 sks from 5648'-5740' (existing)
3. 190 sks Class G (1.15 cuft/sk) from 5126'-5510' (TOC Tagged)
4. 120 sks Class G (1.15 cuft/sk) from 1121'-1650' (TOC Tagged)
5. 300 sks Class G (1.15 cuft/sk) from 500' to surface
6. 15 sks Top Off

Additional Notes:

Initial Potential Test:

Formation Tops:

Niobrara	5397'
D Sand	6156'
J Sand	6246'