

FORM
17
Rev
11/20

State of Colorado
Oil and Gas Conservation Commission

1120 Lincoln Street, Suite 801, Denver, Colorado 80203 Phone: (303) 894-2100 Fax: (303) 894-2109



Document Number:

1557698

BRADENHEAD TEST REPORT

Step 1. Before opening any valves, record all tubing and casing pressures as found.
 Step 2. Collect liquid and gas samples as required; consult Bradenhead Testing and Reporting Instructions and Guidance for field specific Orders at <http://ogcc/reg.html#opguidance>
 Step 3. Conduct Bradenhead test.
 Step 4. Submit Form 17 within 10 days of test. Attach a wellbore diagram if not previously submitted or if wellbore configuration has changed since last wellbore diagram was submitted.
 Step 5. Submit sample analytical results via Form 43.

1. OGCC Operator Number: 10027 3. BLM Lease No: 45880
 2. Name of Operator: C&J Field Services
 4. API Number: 103-09479 5. Multiple completion? Yes No
 6. Well Name: Adam Number: #2
 7. Location (QtrQtr, Sec, Twp, Rng, Meridian): SWNW 5, 2N-103W P
 8. County Rio Blanco 103 9. Field Name: Rangely
 10. Minerals: Fee State Federal Indian

11. Date of Test: 04-04-20
 12. Well Status: Flowing
 Shut In Gas Lift
 Pumping Injection
 Clock/Intermitter
 Plunger Lift
 13. Number of Casing Strings:
 Two Three Liner?

14. EXISTING PRESSURES


Record all pressures as found	Tubing: <u>0</u> Fm: _____	Tubing: _____ Fm: _____	Prod Csg <u>0</u> Fm: <u>OPEN HOLE EMERY</u>	Intermediate Csg: <u>N/A</u>	Surf. Csg <u>N/A</u>
-------------------------------	-------------------------------	----------------------------	---	------------------------------	----------------------

BRADENHEAD TEST

With gauges monitoring production, intermediate casing and tubing pressures, open surface casing (Bradenhead) valve (if no intermediate casing, monitor only the production casing and tubing pressures.) Record pressures at five minute intervals.
 Describe character of flow in "Bradenhead Flow" column: O = No Flow; C = Continuous; D = Down to 0; S = Surge; W = Whisper
 Describe fluid type in "Bradenhead Fluid" column: H = Water H₂O; M = Mud; G = Gas; V = Vapor; L = Liquid Hydrocarbon; H & M = Water & Mud; H & G = Water & Gas; H & V = Water & Vapor; M & G = Mud & Gas; M & V = Mud & Vapor; G & V = Gas & Vapor; H & L = Water & Liquid Hydrocarbon; M & L = Mud & Liquid Hydrocarbon; G & L = Gas & Liquid Hydrocarbon; V & L = Vapor & Liquid Hydrocarbon; N = None

Elapsed Time (Min:Sec)	Fm: Tubing	Fm: Tubing:	Prod Csg PSIG	Intermedia Csg PSIG	Bradenhead Flow:	Bradenhead Fluid:
Buried valve? <input checked="" type="checkbox"/> Yes <input checked="" type="checkbox"/> No <u>N/A</u>						
Confirmed open? <input checked="" type="checkbox"/> Yes <input checked="" type="checkbox"/> No	<input type="checkbox"/>	<input type="checkbox"/>	<input type="checkbox"/>			
BRADENHEAD SAMPLE TAKEN? <u>N/A</u>	<input type="checkbox"/>	<input type="checkbox"/>	<input type="checkbox"/>			
<input type="checkbox"/> Yes <input checked="" type="checkbox"/> No <input type="checkbox"/> Gas <input type="checkbox"/> Liquid	<input type="checkbox"/>	<input type="checkbox"/>	<input type="checkbox"/>			
Character of Bradenhead fluid:	<input type="checkbox"/>	<input type="checkbox"/>	<input type="checkbox"/>			
<input type="checkbox"/> Clear <input type="checkbox"/> Fresh	<input type="checkbox"/>	<input type="checkbox"/>	<input type="checkbox"/>			
<input type="checkbox"/> Sulfur <input type="checkbox"/> Salty <input type="checkbox"/> Black	<input type="checkbox"/>	<input type="checkbox"/>	<input type="checkbox"/>			
Other:(describe) <u>No Bradenhead N/A</u>	<input type="checkbox"/>	<input type="checkbox"/>	<input type="checkbox"/>			

Instantaneous Bradenhead PSIG at end of test: > N/A

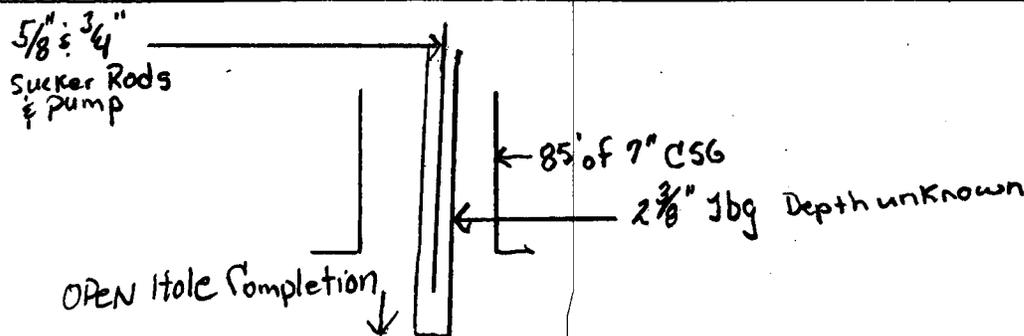

INTERMEDIATE CASING TEST

With gauges monitoring production, intermediate casing and tubing pressures, open the intermediate casing valve. Record pressures at five minute intervals.

Describe character of flow in "Intermediate Flow" column: O = No Flow; C = Continuous; D = Down to 0; S = Surge; W = Whisper
 Describe fluid type in "Intermediate Fluid" column: H = Water H₂O; M = Mud; G = Gas; V = Vapor; L = Liquid Hydrocarbon; H & M = Water & Mud; H & G = Water & Gas; H & V = Water & Vapor; M & G = Mud & Gas; M & V = Mud & Vapor; G & V = Gas & Vapor; H & L = Water & Liquid Hydrocarbon; M & L = Mud & Liquid Hydrocarbon; G & L = Gas & Liquid Hydrocarbon; V & L = Vapor & Liquid Hydrocarbon; N = None.

Buried valve? <input checked="" type="checkbox"/> Yes <input checked="" type="checkbox"/> No <i>N/A</i> Confirmed open? <input checked="" type="checkbox"/> Yes <input checked="" type="checkbox"/> No	Elapsed Time (Min:Sec)	Fm: Tubing	Fm: Tubing:	Prod Csg PSIG	Intermediate Csg PSIG	Intermediate Flow:	Intermediate Fluid:
		<input type="checkbox"/>	<input type="checkbox"/>	<input type="checkbox"/>			
INTERMEDIATE SAMPLE TAKEN? <i>N/A</i> <input checked="" type="checkbox"/> Yes <input checked="" type="checkbox"/> No <input checked="" type="checkbox"/> Gas <input checked="" type="checkbox"/> Liquid		<input type="checkbox"/>	<input type="checkbox"/>	<input type="checkbox"/>			
Character of Intermediate fluid: <i>N/A</i> <input type="checkbox"/> Clear <input type="checkbox"/> Fresh <input type="checkbox"/> Sulfur <input type="checkbox"/> Salty <input type="checkbox"/> Black Other:(describe) <i>85' of 7" CSB with 12 Sack of Cement. Open Hole Completion</i>		<input type="checkbox"/>	<input type="checkbox"/>	<input type="checkbox"/>			
Instantaneous Intermediate Casing PSIG at end of test: > _____							

Comments:

I hereby certify all statements made in this form are, to the best of my knowledge, true, correct, and complete.

Test Performed By: Curt Dembowski Title: OWNER Phone: (1) 970-629-5161
 Signed: Curt Dembowski Title: OWNER Date: 04-04-22
 Witnessed By: _____ Title: _____ Agency: _____