


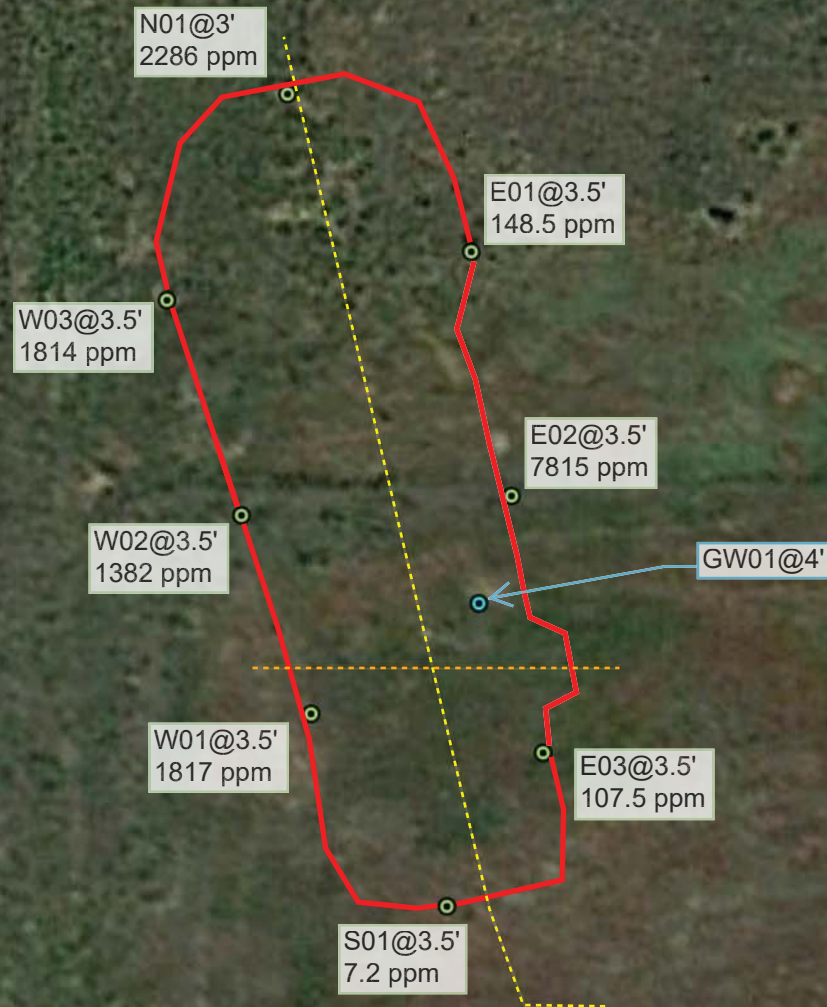

Rinn Valley Pipeline Corridor  
Sec 21, T2N R68W  
KPK Impact Assessment



Legend

- Excavation boundary
- Flowline - KPK 8" and 2"
- Flowline - XOG 12"
- Sample - Groundwater
- Sample - Soil

Google Earth

© 2018 Google

80 ft