




DRILLING COMPANY, INC. **WICHITA, KANSAS**

Current Wellbore Diagram

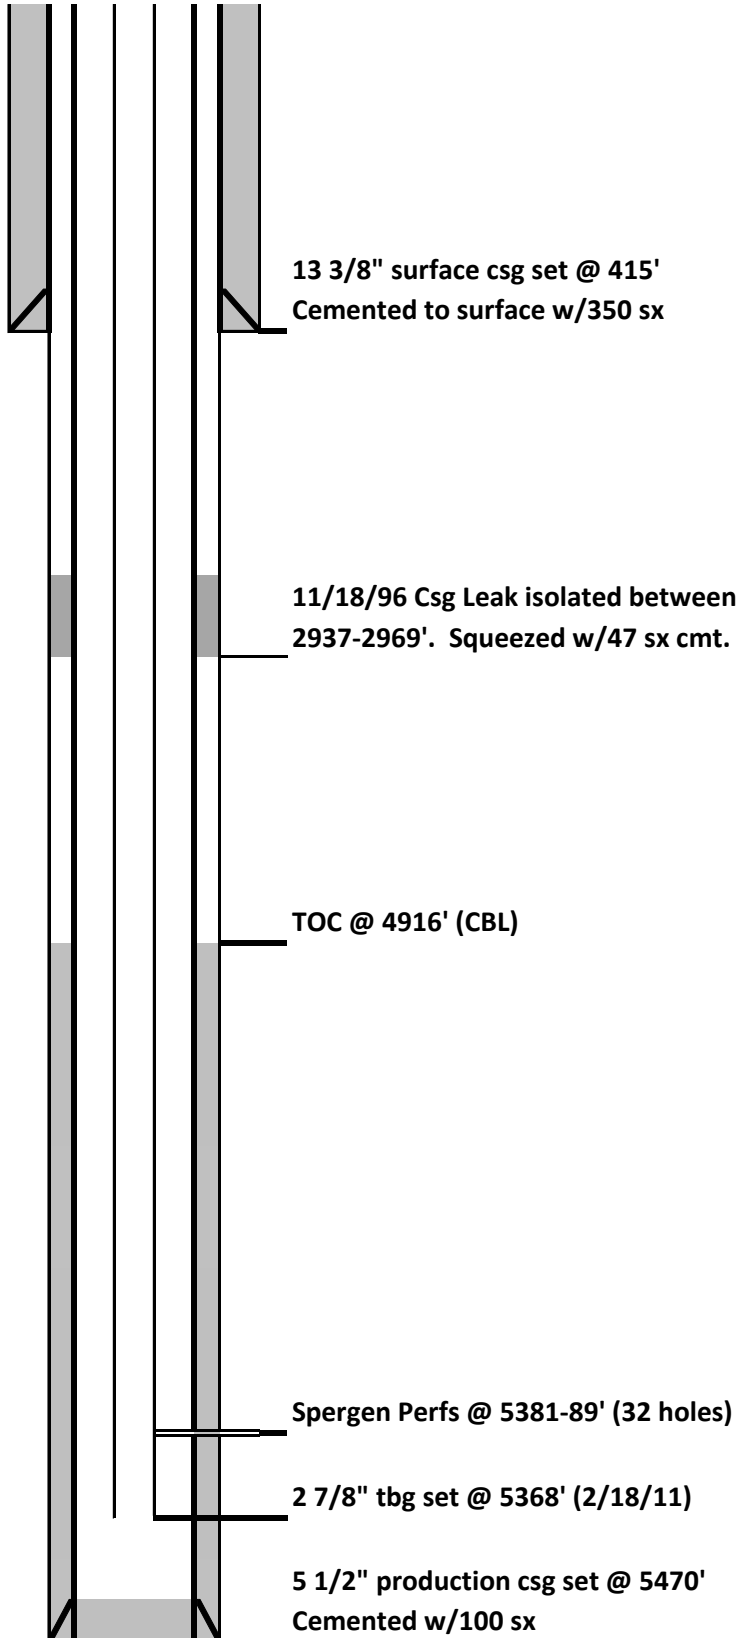

Date:	4/6/2016
Well Name:	UPRC-Hiss #1-X
Location:	790' FNL & 626' FEL
	NE/4 NE/4 29-13S-44W
County:	Cheyenne
State:	Colorado
API:	05-017-07395
GL:	4227'
KB:	4239'
Spud Date:	9/5/1993
DFP Spergen:	10/6/1993

<u>Formation</u>	<u>Log Top</u>
NIOBRARA	700
FORT HAYS	1403
CODELL	1455
CARLILE	1480
GREENHORN	1645
DAKOTA	1848
CHEYENNE	2131
MORRISON	2221
BLAINE	2658
CEDAR HILLS	2931
STONE CORRAL	3089
SHAWNEE	4124
LANSING	4354
MARMATON	4713
KEYES	5249
ST LOUIS	5294
SPERGEN	5358
CHEROKEE K	4854
MORROW	5134
KEYES	5249
ST LOUIS	5294
SPERGEN	5358