BISON OIL & GAS

Final - As Plugged Wellbore Schematic

Well Name:	Alice Nay 2	Date Prepared:	11/23/2021
Location:	1980' FSL, 1830' FEL, NWSE Sec 14, T9N, R58W	Last Updated:	6/15/2022
County	Weld	Spud Date:	6/9/1960
API #:	05-123-05652	Completion Start Date:	N/A
Co-ordinates:	40.749665 / -103.828185	Last Workover Date:	N/A
Elevations:	GROUND: Unknown	Prepared by:	Jake Van Bramer
	KB: Unknown	Updated by:	--
Depths (KB):	PBTD: --		
	TD: 5662'		

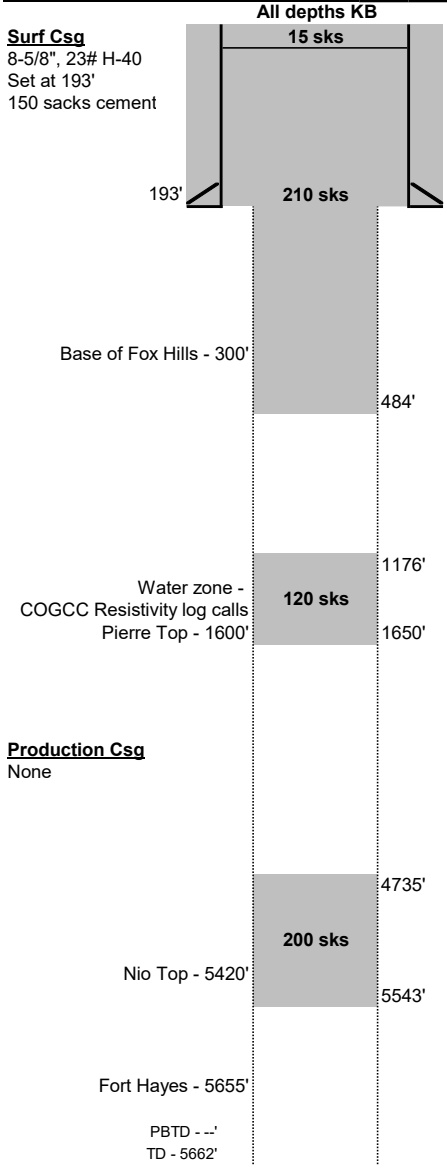

Hole Size
Unknown
0-193'

7.875"
193'-5662'

PBTD - --'
TD - 5662'

Surface Casing:
Unknown Hole Size, assumed to be 12.25"
Landed 8-5/8", 23# Grade H-40 casing at 193'
Cemented with 150 sks

Production Casing:
No production casing

Open Hole:
193'-5662', hole size 7-7/8"

Tubing:
None

Rods:
None

Perforations:
None

P&A Plugs:
1. 200 sks Class G (1.15 cuft/sk) from 4735'-5543' (TOC Tagged)
2. 120 sks Class G (1.15 cuft/sk) from 1176'-1650' (TOC Tagged)
3. 210 sks Class G (1.15 cuft/sk) from 484' to surface
4. 15 sks Top Off

Additional Notes:

Initial Potential Test:

Formation Tops:

Niobrara	5420'
Fort Hayes	5655'