



FORM F-106




00485836

RECEIVED

FEB 06 1984

COLO. OIL & GAS CONS. COMM.

R. 55 W

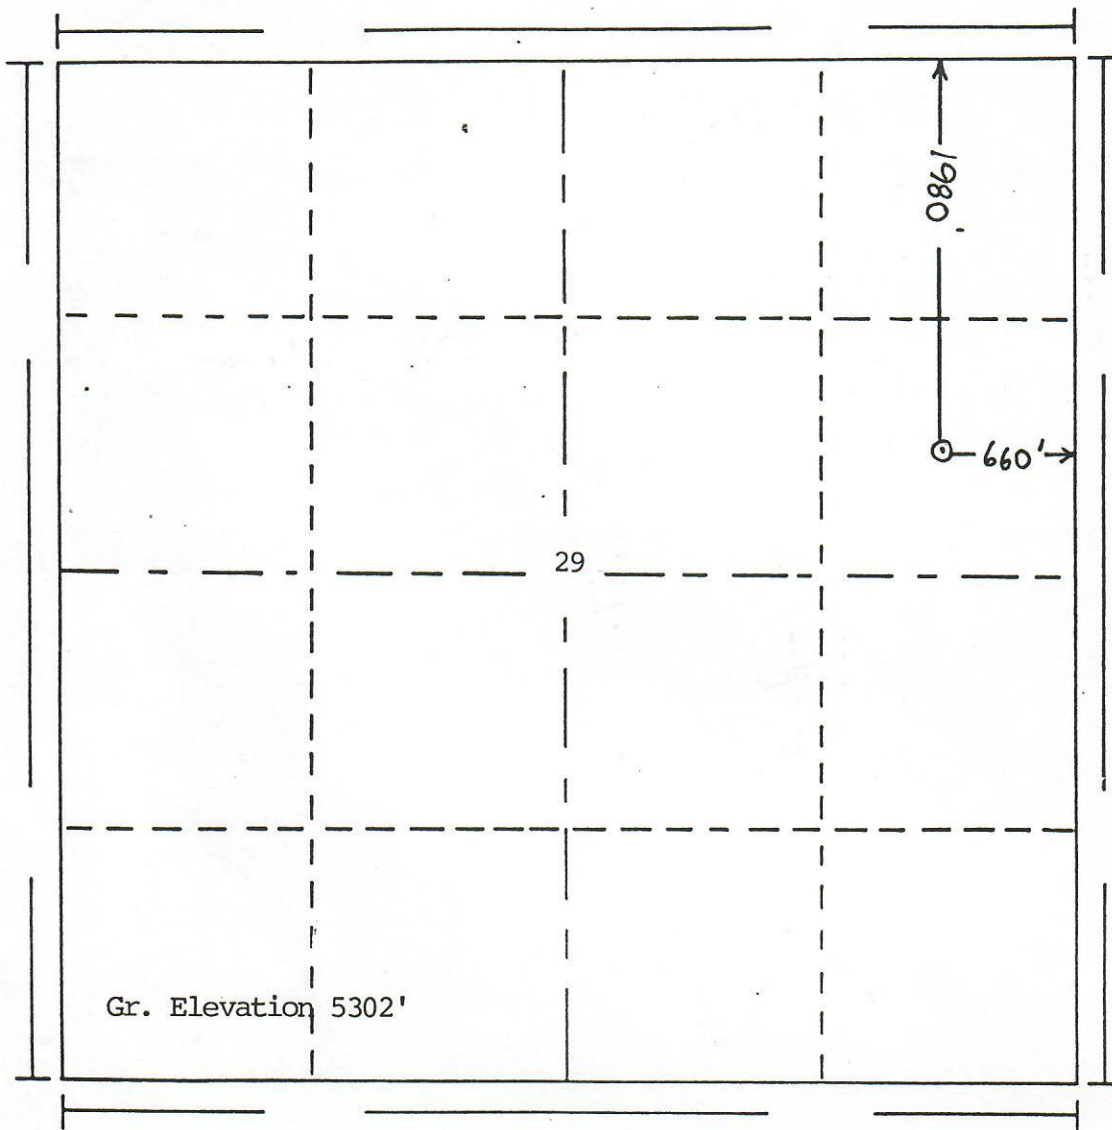


T.11 S

Scale... 1" = 1000'

Powers Elevation of Denver, Colorado
has in accordance with a request from Terry Rooney
for Sohio Petroleum Co.
determined the location of 29-8 Sellon
to be 1980fml, 660fel Section 29 Township 11 S
Range 55 W of the 6th Principal Meridian
Lincoln County, Colorado

I hereby certify that this plat is an
accurate representation of a correct
survey showing the location of
29-8 Sellon

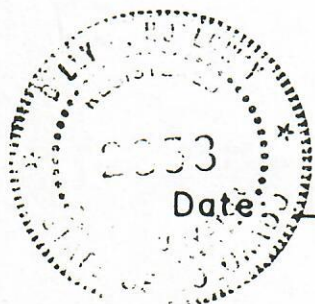

Date

1-31-84

B. J. Rooney
Licensed Land Surveyor No. 2853
State of Colorado