


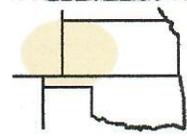

ROBINSON SERVICES
Oil Field and Construction Staking
 Garden City, Kansas 67846
 Office/Fax: (620) 276-6159
 Cell: (620) 272-1499
 robinsonservices@cox.net

112407-b
 PLAT NO.

7234
 INVOICE NO.



Robinson Services of Garden City, Kansas has in accordance with a request from Kerry Halde for Wiepking Fullerton has relocated and determined the "29-8 Sellon" well to be 1978 FNL - 640' FEL (location footages are 90 degree of sec. lines) of Section 29, Township 11 South, Range 55 West of the 6th Principal Meridian, Lincoln County, Colorado.

RECEIVED
 DEC 10 2007



Date: Staked on 10/29/07 - Drawn on 11/24/2007 **By:** Staked by Burt West - Drawn by Gabe Q.


COGCC

Basis of Elevation Spot: USGS BM = Long, PID = KJ0520, H-Order = Second, V-Order = unknown, Stability = unknown, PDOP = 2.2, Sats = 8, US NAD 83 CO-C 0502, Lat = 39.076975494, Long = -103.648264508, elev. = 5435.0' adj. gr US ft

Notes: Location falls in dry land corn stubble & drill pad area will need approx. 3 ft fill West, 2 ft of cut North, 3 ft of cut East, level South.
 There are (NO) apparent improvements within 200 ft staked location
 The ground elevation at staked location: staked loc. = 5299.9' gr.
 This drawing does not constitute a monumented survey or a land survey plat

Basis of Bearings: Bearings were determined based on the East line of section 29 to bear S 01° 41' 17" E with all other bearings contained herein relative thereto.

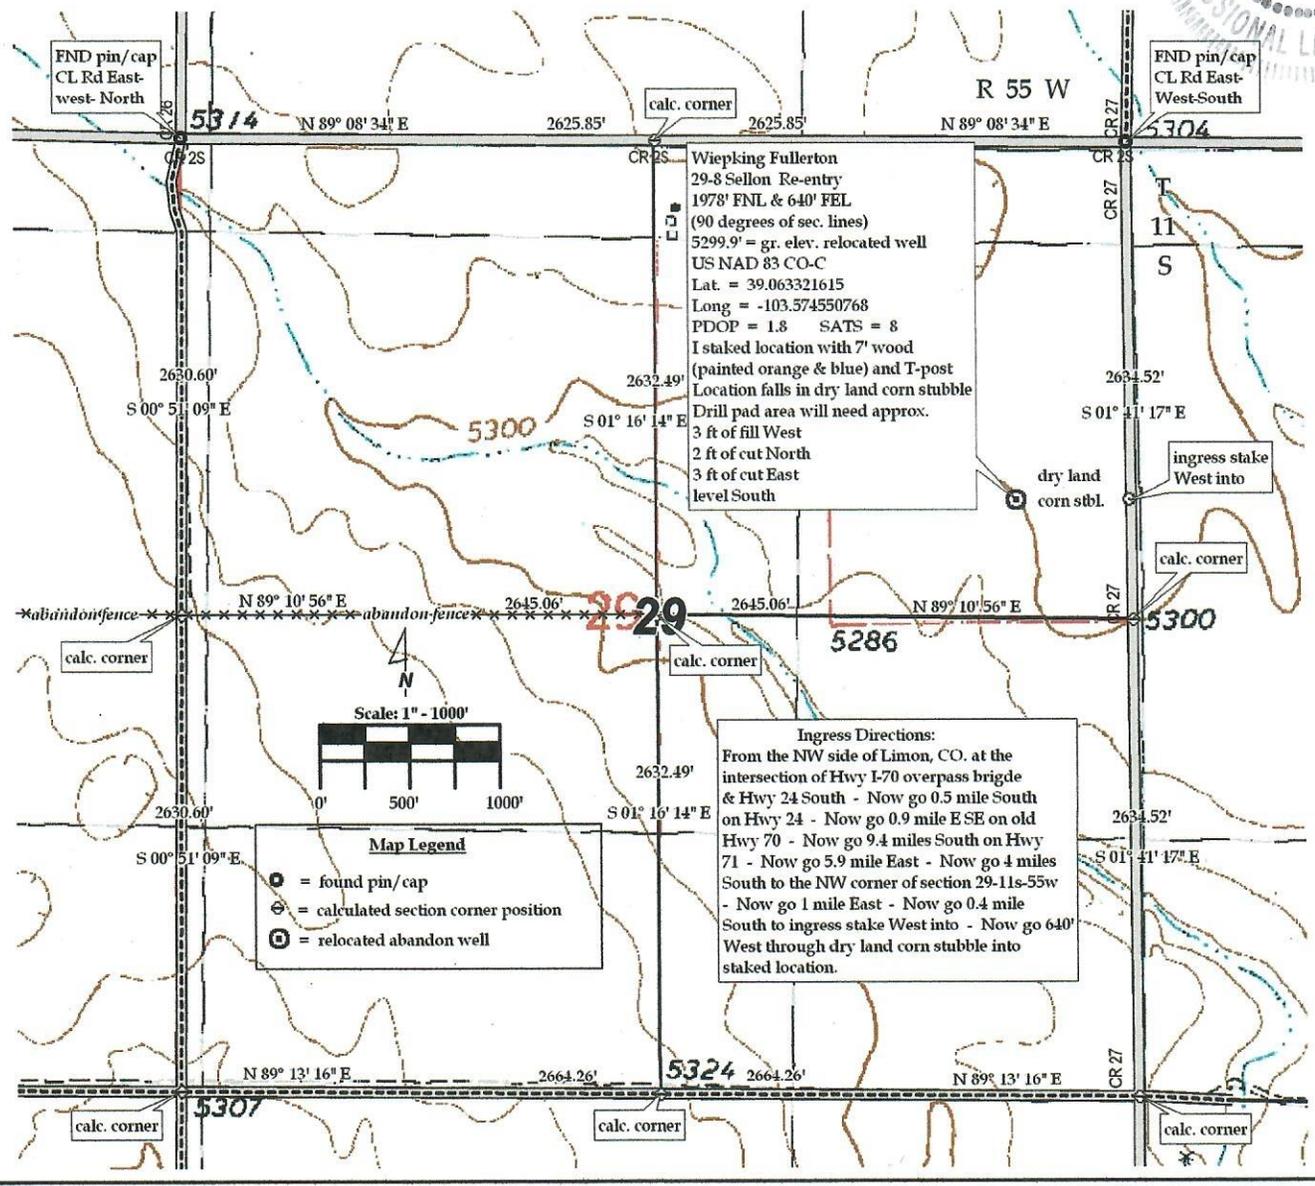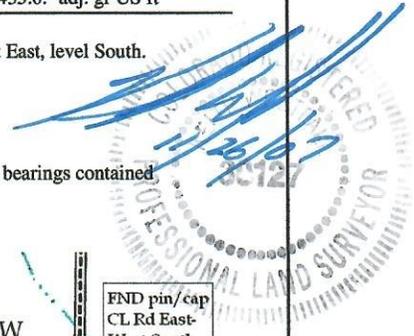

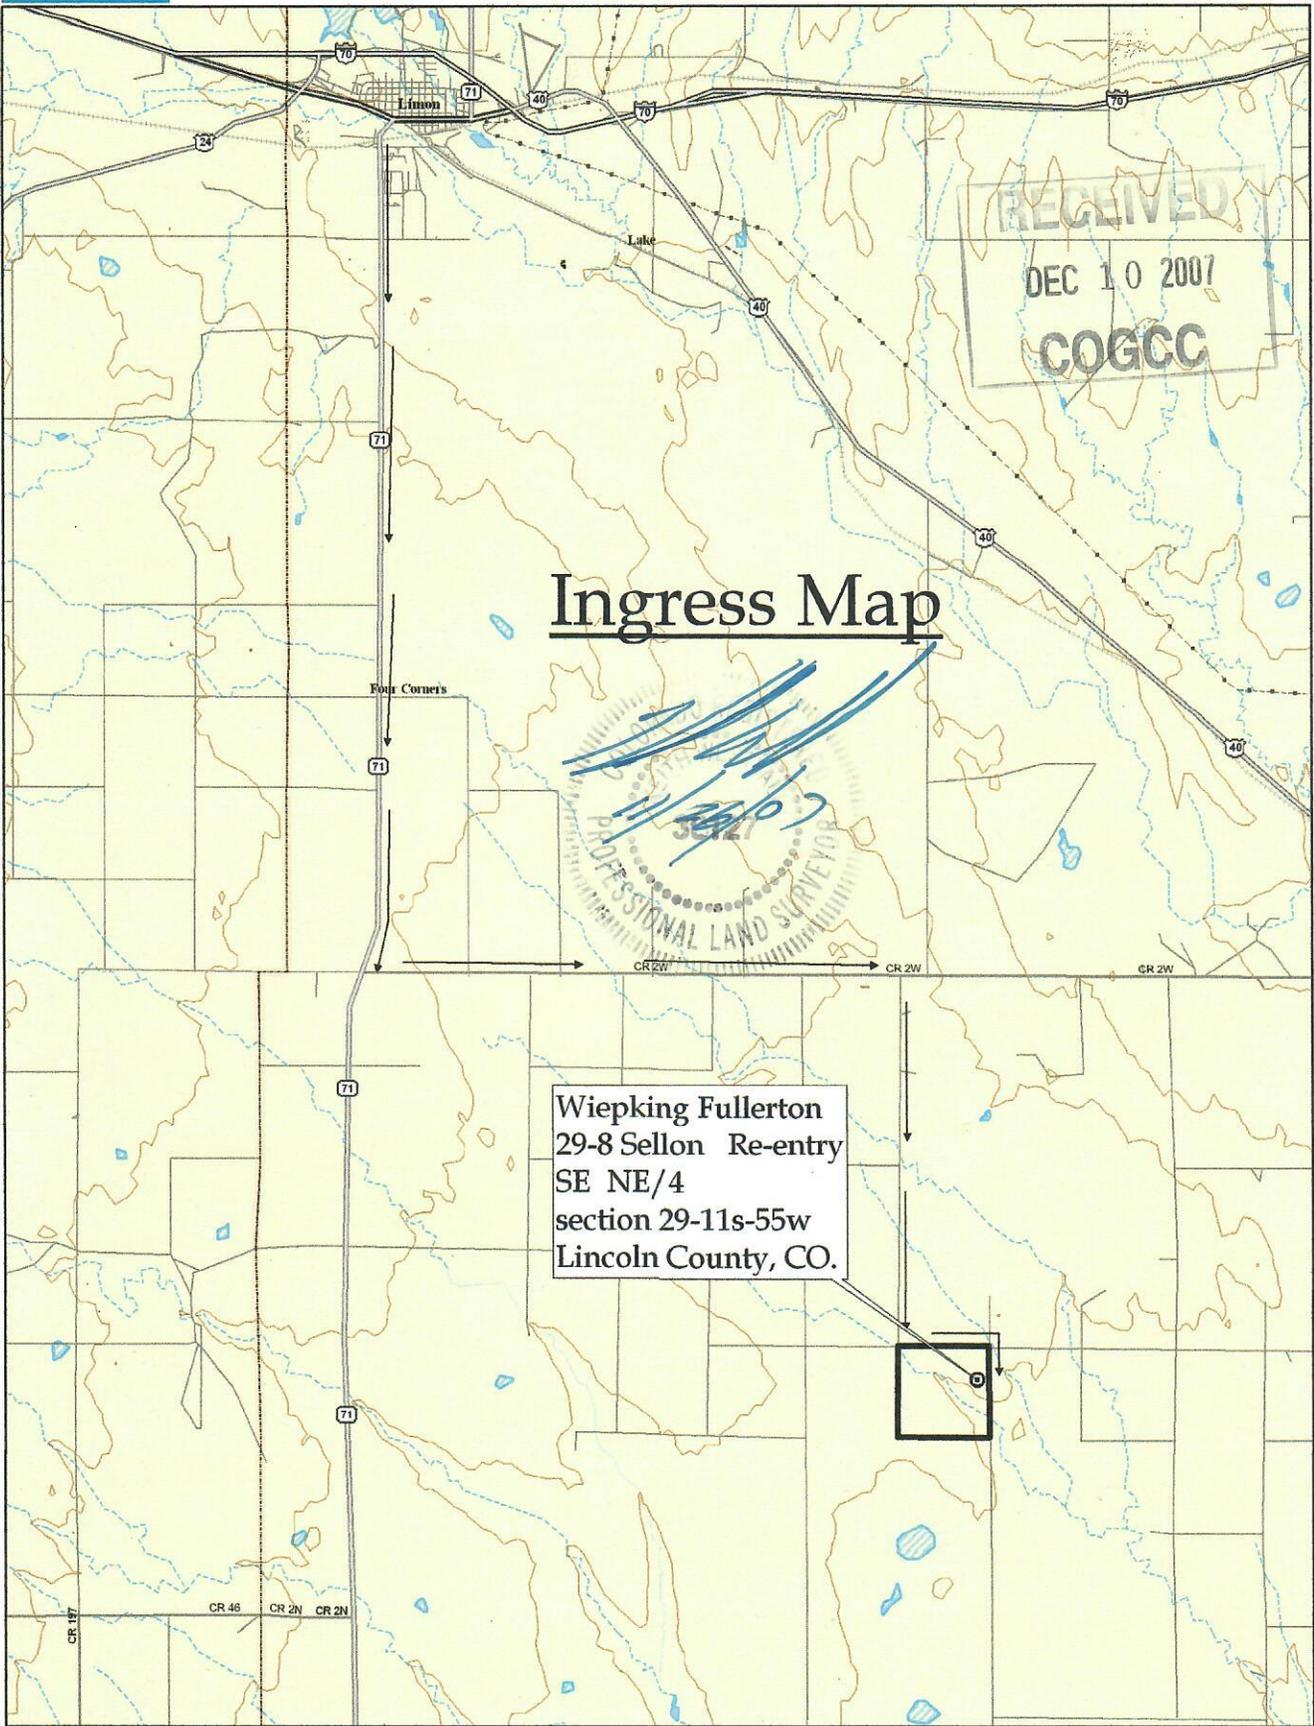

Ingress Map

Wiepking Fullerton
 29-8 Sellon Re-entry
 SE NE/4
 section 29-11s-55w
 Lincoln County, CO.

