




FORM F-106



RECEIVED
APR 5 1974 N
GOLD OIL & GAS CONS. CO. INC.

R. 61W

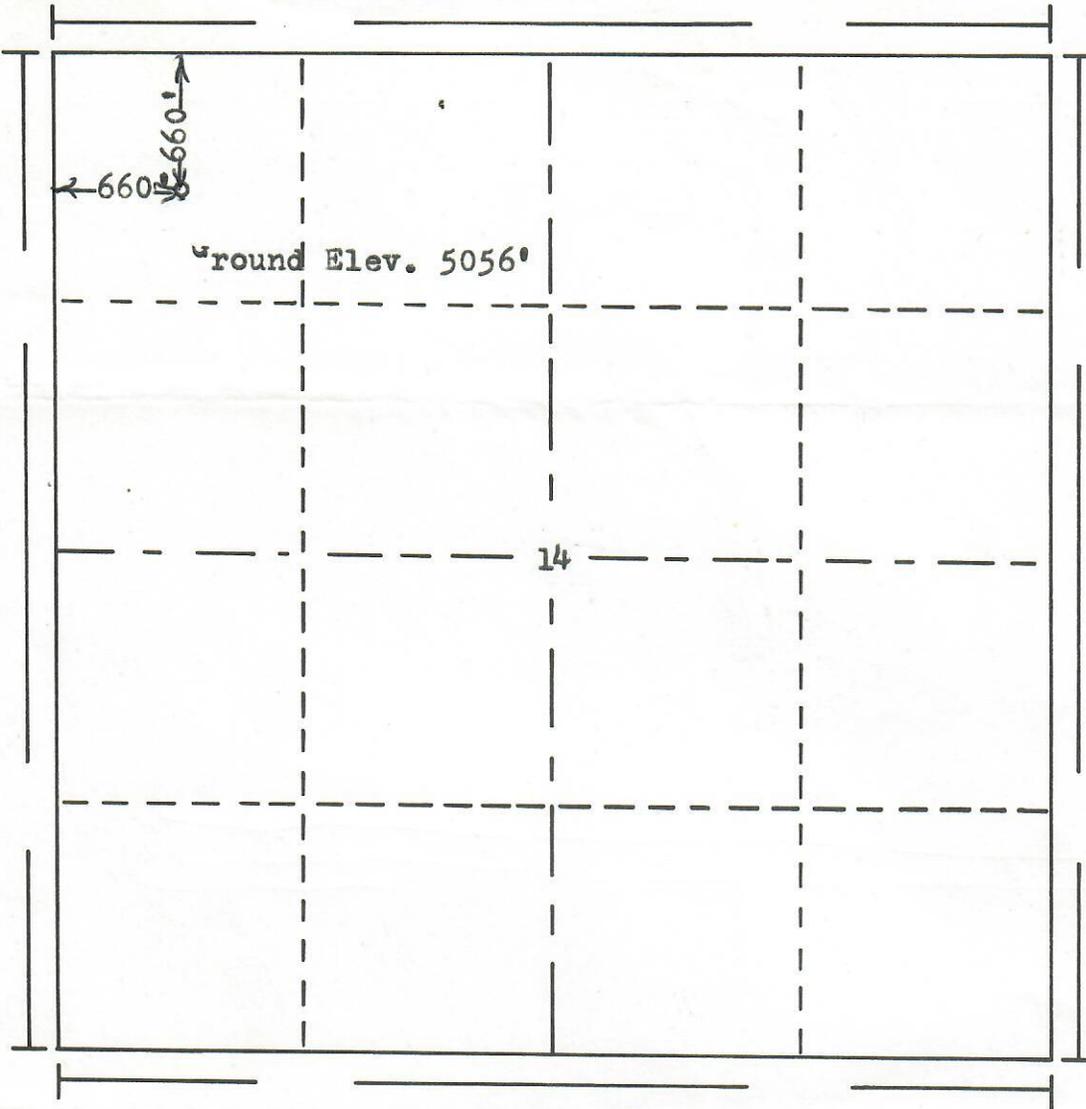

T.
3
S

Scale... 1" = 1000'

Powers Elevation Company, Inc. of Denver, Colorado
 has in accordance with a request from Me. Mossel
 for Tom Jordan
 determined the location of No.1 Turecek
 to be CNW NW Section 14 Township 3S
 Range 61W of the 6th principal Meridian
 Adams County, Colorado

I hereby certify that this plat is an
 accurate representation of a correct
 survey showing the location of

Date: 3-27-74

Billy B. Hollaway
 Licensed Land Surveyor No. 2853
 State of Colorado