P&A Wellbore For State

Well Name: UHRICH E27-01

Land, Original Hole, 7/18/2022 1:33:25 PM

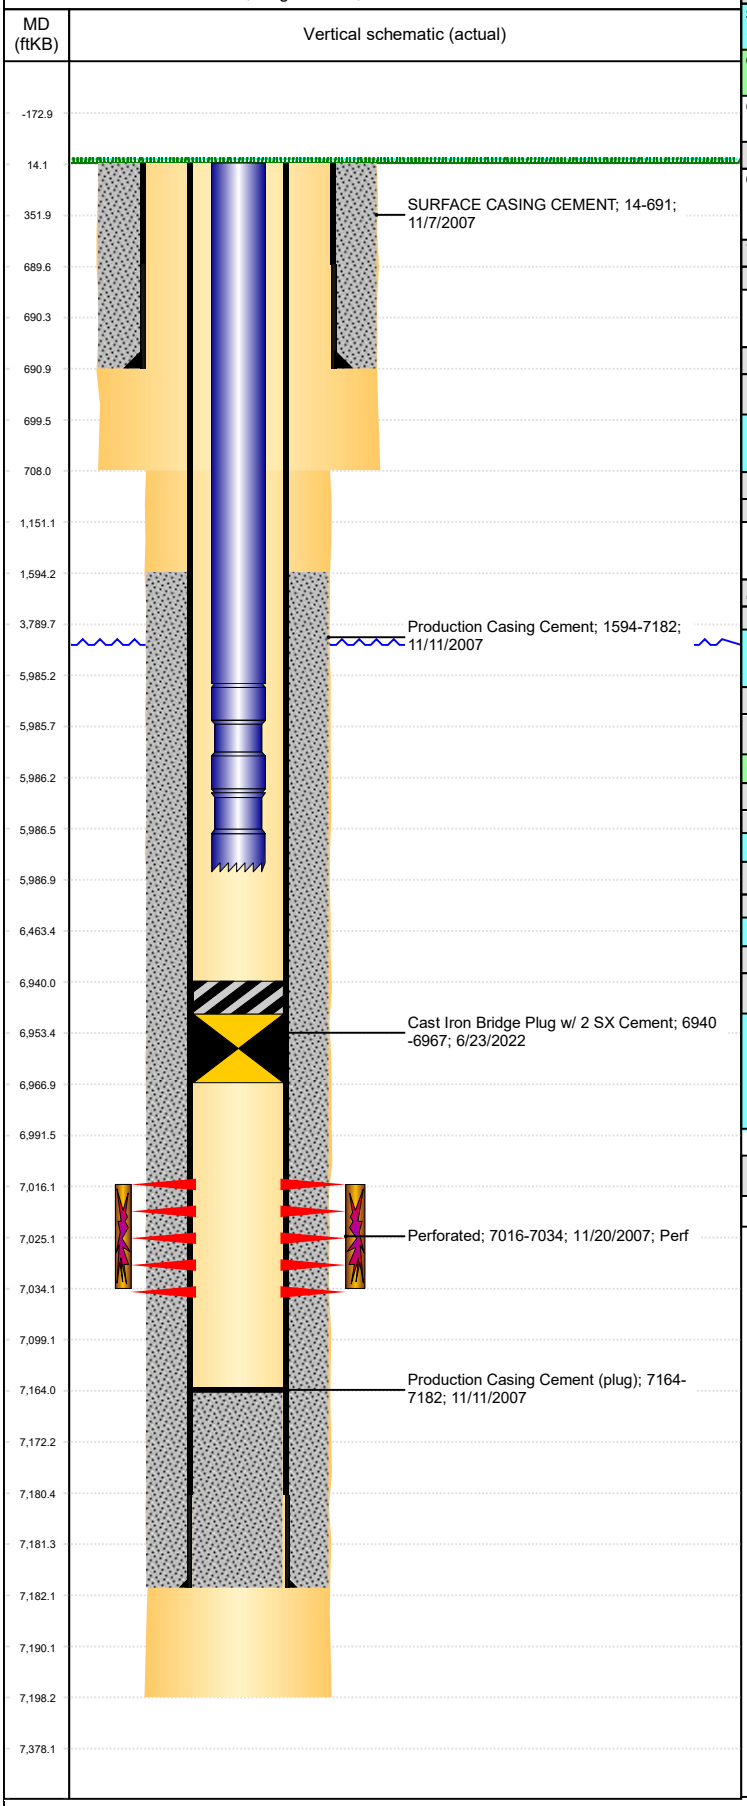

Well Header

Surface UWI	Business Unit	Gov Auth Dist	Prod Tree Loc
0512324413	Rockies		Land

Orig. KB to Gnd (ft)	Original Spud Date	Abandon Date	Well Sub-Status	High…
14.00	11/7/2007		TA	N

Comment
LITTLE INFO IN FILE. STATE SHOWS SHUT IN SINCE OCT 2016.

Surface Location (Congressional)

Qtr 3	Qtr 4	Section	Twnshp	Twnsh…	Range	Rng E/…	Latitude (°)	Longitude (°)
NE	NE	27	6	N	65	W	40.462422503	-104.642522839

Wellbore Sections

Section Des	Hole Size (in)	Act Top (ftKB)	Act Btm (ftKB)
SURFACE	12 1/4	14.0	708.0
PRODUCTION	7 7/8	708.0	7,198.0

Casing Strings

Csg Des	Run Date	OD (in)	Wt/Len (lb/ft)	Grade	Top Depth (MD) (ftKB)	Set Depth (MD) (ftKB)
Surface	11/7/2007	8 5/8	24.00	J-55	14	691
Production Casing	11/11/2007	4 1/2	11.60	M-80	14	7182

Cement

Des	Start Date	Top (ftKB)	Btm (ftKB)
SURFACE CASING CEMENT	11/7/2007	14.0	691.0
Production Casing Cement	11/11/2007	1,594.0	7,182.0

Zone Statuses

Zone Name	Status Date	Status	Fluid Type	Job	Prod Method
CODELL	4/1/2008	PR	Oil		Flowing
CODELL	2/22/2010	PR			Flowing

Perforation Data

Linked Zone	Explosive Type	Entered Shot Total	Top (ftKB)	Btm (ftKB)	Date
CODELL, Original Hole		72	7,016.0	7,034.0	11/20/2007

Stimulation Intervals

Zone	Start Date	Top (ftKB)	Btm (ftKB)
CODELL, Original Hole	12/11/2007	7,016.0	7,034.0

Other In Hole

Run Date	Des	Make	OD (in)	Top (ftKB)	Btm (ftKB)
6/23/2022	Cast Iron Bridge Plug w/ 2 SX Cement		3.99	6,940.0	6,967.0

Logs

Date	Type	Depth Top (MD) (ftKB)	Btm (ftKB)
11/11/2007	COMPENSATED DENSITY	2,860	7,176.0
11/11/2007	INDUCTION	691	7,196.0
11/20/2007	CBL/CCL/GR	1,430	7,159.0
12/1/2015	GYRO	0	6,900.0

Plug Back Total Depths

Date	Type	Com	PBTD (ftKB)
11/20/2007	FILL	DEPTH LOGGER ON CBL	7,164