

BORE DIAMETERS (IN.)

6 1/4"

**PLUG NICKEL OIL CO**

HUSKY 51


API #05-103-07233

LEASE #COC06412

SEC.5,T1N,R101W,NWSW

RIO BLANCO COUNTY

7/12/2022

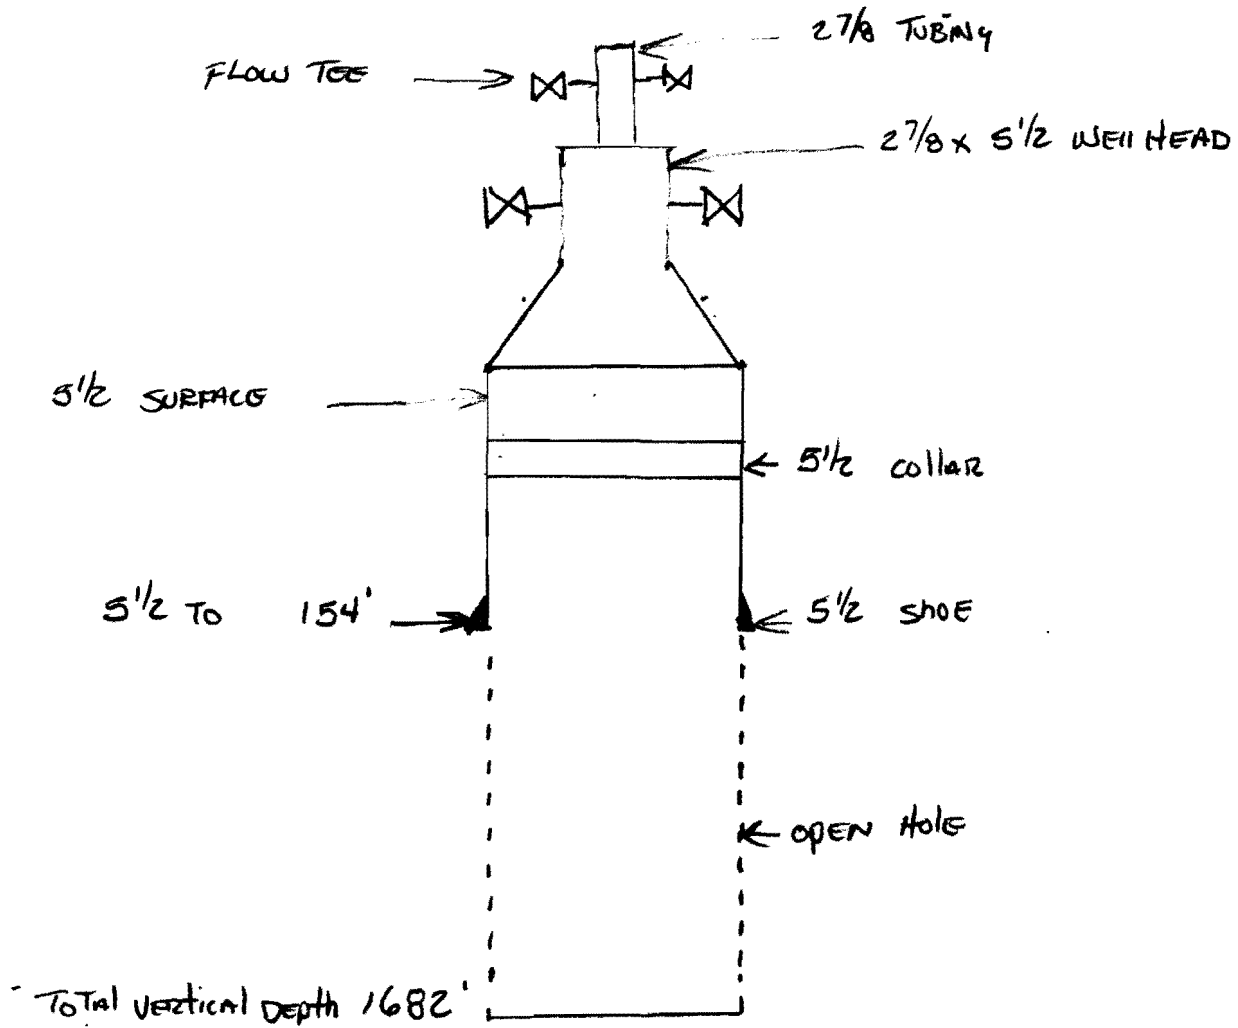

HUSKY 51