



STATE OF COLORADO
DIVISION OF WATER RESOURCES
OFFICE OF THE STATE ENGINEER, GROUND WATER SECTION
PERMIT TO USE GROUND WATER

Feb. 21/61

This permit is issued to the applicant of the address shown below authorizing the use of ground water in the amount, for the use as indicated on/at the location given in the application, and as of the initiation date shown.

Form C(Rev.)
7-58 5M

STATE OF COLORADO
APPLICATION FOR USE OF GROUND WATER
(Use Indelible Pencil or Typewriter)

Amended Permit 2781-F

Applicant Sundance Oil Company

P.O. Address 1430 Denver Club Bldg.
Quantity applied for 30 gpm or
AF Storage

Used for Secondary Recovery Purposes

on/at Busy Bee Field
(legal description of land site)

Total acreage irrigated and other rts.
ESTIMATED DATA OF WELL

Hole size: 8-5/8 in. to 545 ft.
8-5/8"

Casing Plain 18 in. from 0 to 147 ft.
Perf. 18 in. from 0 to 147 ft.
18 in. from 0 to 147 ft.

PUMP DATA: Type Fairbanks HP 6 Size Outlet

Use initiation date Jan. 11 19 61
(Use Supplemental pages for additional data)

AMENDED PERMIT

THIS APPLICATION APPROVED

NO. 2781-F

DATE FEB 21 1961 19 61


LOCATION OF WELL
County Adams

Ne. NE Sect. 8 Twp. 3S

Rge. 60W 6th P.M. OR

Street Address or Lot & Block No.

Town or Subdivision

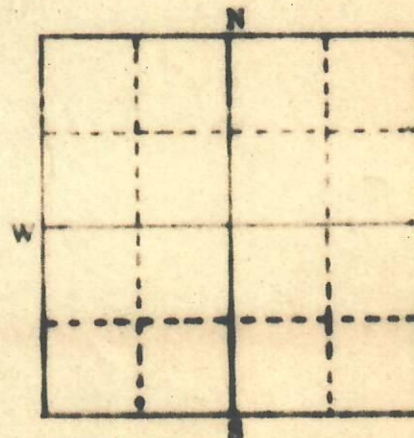

Locate well in 40 acre (small) square as near as possible.

\$25.00 fee required for Industrial, Commercial or Irrigation uses.

Applicant Sundance Oil Company

Agent or Driller Burton Paine No. 59

Address Byers, Colorado

NOTE - SATISFACTORY COMPLETION REQUIRED FOR APPROVAL OF APPLICATION INDICATED.

SEAL

J. B. Whitton
STATE ENGINEER
Geo. W. Colburn

By

Authorized Agent