




R. 60 W.


5210'

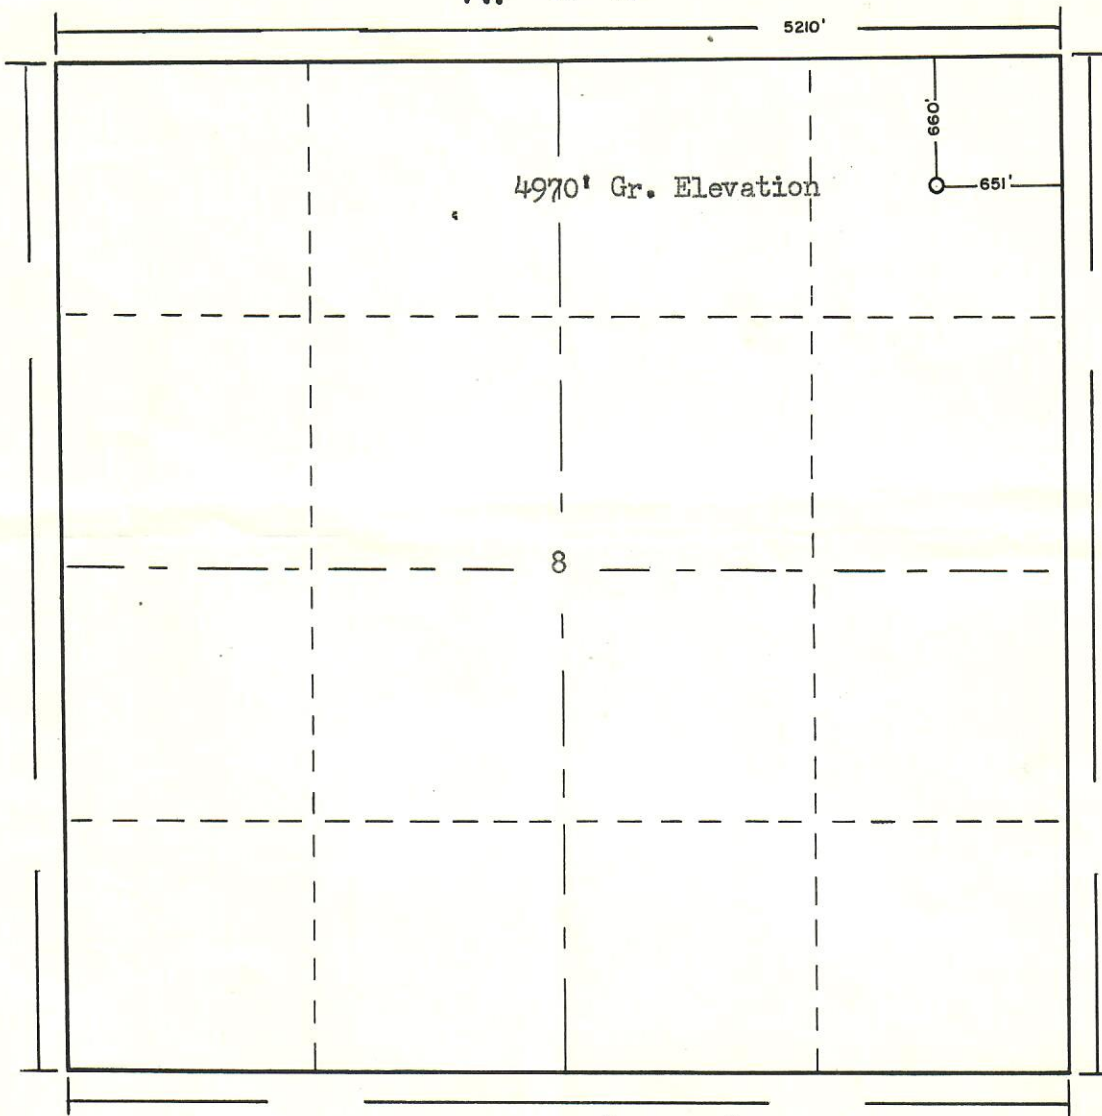

T.
3
S.

Scale ... 1" = 1000'

Powers Elevation Company of Casper, Wyoming
has in accordance with a request from Mr. Brinkerhoff
for Brinkerhoff Drilling Company determined the
Location of #4 Flader
to be C NE NE Section 8 Township 3 South
Range 60 West 6th Principal Meridian
Adams County, Colorado.

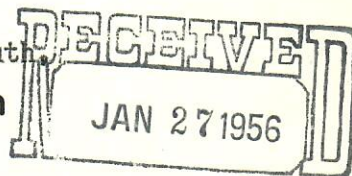

The above Plat shows the location of the well site
in said section.

CONSERVATION COMMISSION

Powers Elevation Company
by: *Burr Leibert*

Date: 1-20-56

Registered Land Surveyor
Burr Leibert