



VERBAL REQUESTS


NOTICE OF INTENTION TO DRILL X

Bonding Status

Ozark (Jeff Hawks Blanket)

NOTICE OF INTENTION TO ABANDON \_\_\_\_\_

OTHER \_\_\_\_\_

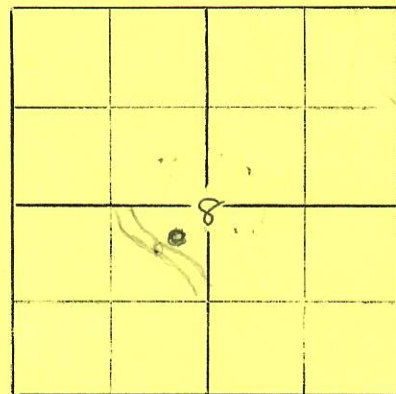

COMPANY Oil Inc. - Ozark Corp ADDRESS \_\_\_\_\_

WELL NO. A-2

BY Betty Todd PHONE NO AC 2973  
EXT. \_\_\_\_\_

LEASE Flader

TITLE \_\_\_\_\_

COUNTY Adams

FIELD W/C

Location 100 feet W & 50 N of Center  
NE SW Section 8 Township 3f Range 60W Meridian 6<sup>th</sup> PM  
(quarter quarter)  
\_\_\_\_\_ feet from \_\_\_\_\_ Section line and \_\_\_\_\_ feet from \_\_\_\_\_ Section line  
N or S E or W

DETAILS OF PLAN OF WORK: T.D. 6565 FORMATION "J" Sand

ESTIMATED DATE OF WORK: March 15 ESTIMATED TIME: \_\_\_\_\_

150' - 8 5/8" on sup to protect surface  
all owned by Flader lease  
Skell leased & Formed out Oil Inc & Ozark  
Due to river (500' wide) it was necessary  
to move location as above

APPROVED BY: \_\_\_\_\_

DATE 3/13/59

3-16-59

Kirk Dyer with Skell called. They have entire section under lease. Will send in letter. OK