




VERBAL REQUESTS

NOTICE OF INTENTION TO DRILL _____

Bonding Status _____

NOTICE OF INTENTION TO ABANDON _____

OTHER _____

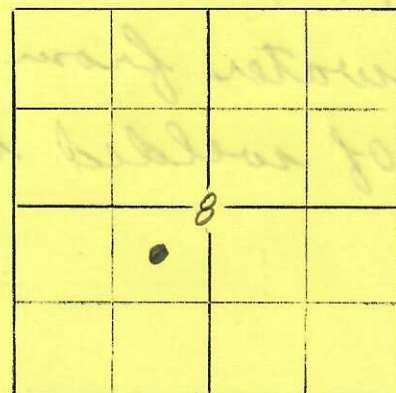

COMPANY Brinkerhoff Drlg. ADDRESS _____

WELL NO. A-2 BY Betty Todd PHONE NO. _____

LEASE Flader TITLE _____ EXT. _____

COUNTY Adams FIELD W.C.

Location NESW Section 8 Township 35 Range 60W Meridian 6
(quarter quarter)
_____ feet from _____ Section line and _____ feet from _____ Section line
N or S E or W

DETAILS OF PLAN OF WORK: T.D. est. @ 6550 FORMATION Jsd.

ESTIMATED DATE OF WORK: 4-3-59 ESTIMATED TIME: Midnight ±
12-4-59

Sample top D-6450
" " J-6475

Cement Plugs @ bottom of surface Pipe
2nd @ surface - Heavy mud
in hole.

APPROVED BY: Frank Bero

DATE 4-3-59

4/6/59 - Well to be made into water well. Necessary letter from Flader will be submitted & operator will get approval from Gr.-Water Dept. & submit copy to us. Per phone call from Brinkerhoff (Betty Todd). H.H. Monell

VERBAL REQUESTS

5/1/59 checked location. well flowing clear
water from 1 1/2" pipe sticking \pm 1' out
of welded top over surface csg.

Hack

COMPANY _____ ADDRESS _____
WELL NO. _____ BY _____ PHONE NO. _____
EXT. _____
LEASE _____ TITLE _____
COUNTY _____ FIELD _____

Location _____ Section _____ Township _____ Range _____ Meridian _____
(quarter quarter)
feet from _____ Section line and _____ feet from _____ Section line
N or S E or W

DETAILS OF PLAN OF WORK: T.D. _____ FORMATION _____
ESTIMATED DATE OF WORK: _____ ESTIMATED TIME: _____

APPROVED BY: _____ DATE: _____

