



STATE OF COLORADO  
APPLICATION FOR USE OF GROUND WATER  
(Use Indelible Pencil or Typewriter)

RECEIVED

JUN 5-1959  
GROUND WATER SECT.

LOCATION OF WELL COLORADO

County Adams STATE ENGINEER


NE,  $\frac{1}{4}$  SW,  $\frac{1}{4}$  Sect. 8, Twp. 3.5

Rge. 60 ~~W~~ W P.M. OR

Street Address or Lot & Block No.

Town or Subdivision

N

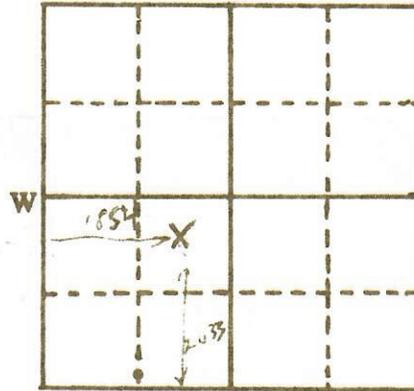

Locate well in 40 acre (small) square as near as possible.

S

\$25.00 fee required for Industrial, Commercial or Irrigation uses.

Applicant The Hader Land Co

Agent or Driller H. C. F. [Signature]

Address 3975 York St.

Applicant Hader Land Company

P.O. Address 3975 York St. Denver

Quantity applied for 5 to 6 gpm or (Flowing well) \_\_\_\_\_ AF Storage

Used for Stock Water Purposes

on/at N.E. 1/4 & N.W. 1/4 8-3-60 (legal description of land site)

Total acreage irrigated and other rts. ESTIMATED DATA OF WELL

Hole size: 6 3/4 in. to 6.5 ft. reduced to 1" in. to \_\_\_\_\_ ft.

Casing Plain 8 in. from 1 to 27.88 ft. \_\_\_\_\_ in. from \_\_\_\_\_ to \_\_\_\_\_ ft.

Perf. \* in. from \_\_\_\_\_ to \_\_\_\_\_ ft.

Open hole \_\_\_\_\_ in. from \_\_\_\_\_ to \_\_\_\_\_ ft.

PUMP DATA: Type none HP \_\_\_\_\_ Size \_\_\_\_\_ Outlet \_\_\_\_\_

Use initiation date 4/15 1959. (Use Supplemental pages for additional data)

THIS APPLICATION APPROVED  
NO. \_\_\_\_\_  
DATE \_\_\_\_\_ 19\_\_\_\_

NOTE — SATISFACTORY COMPLETION REQUIRED FOR APPROVAL OF APPLICATION