
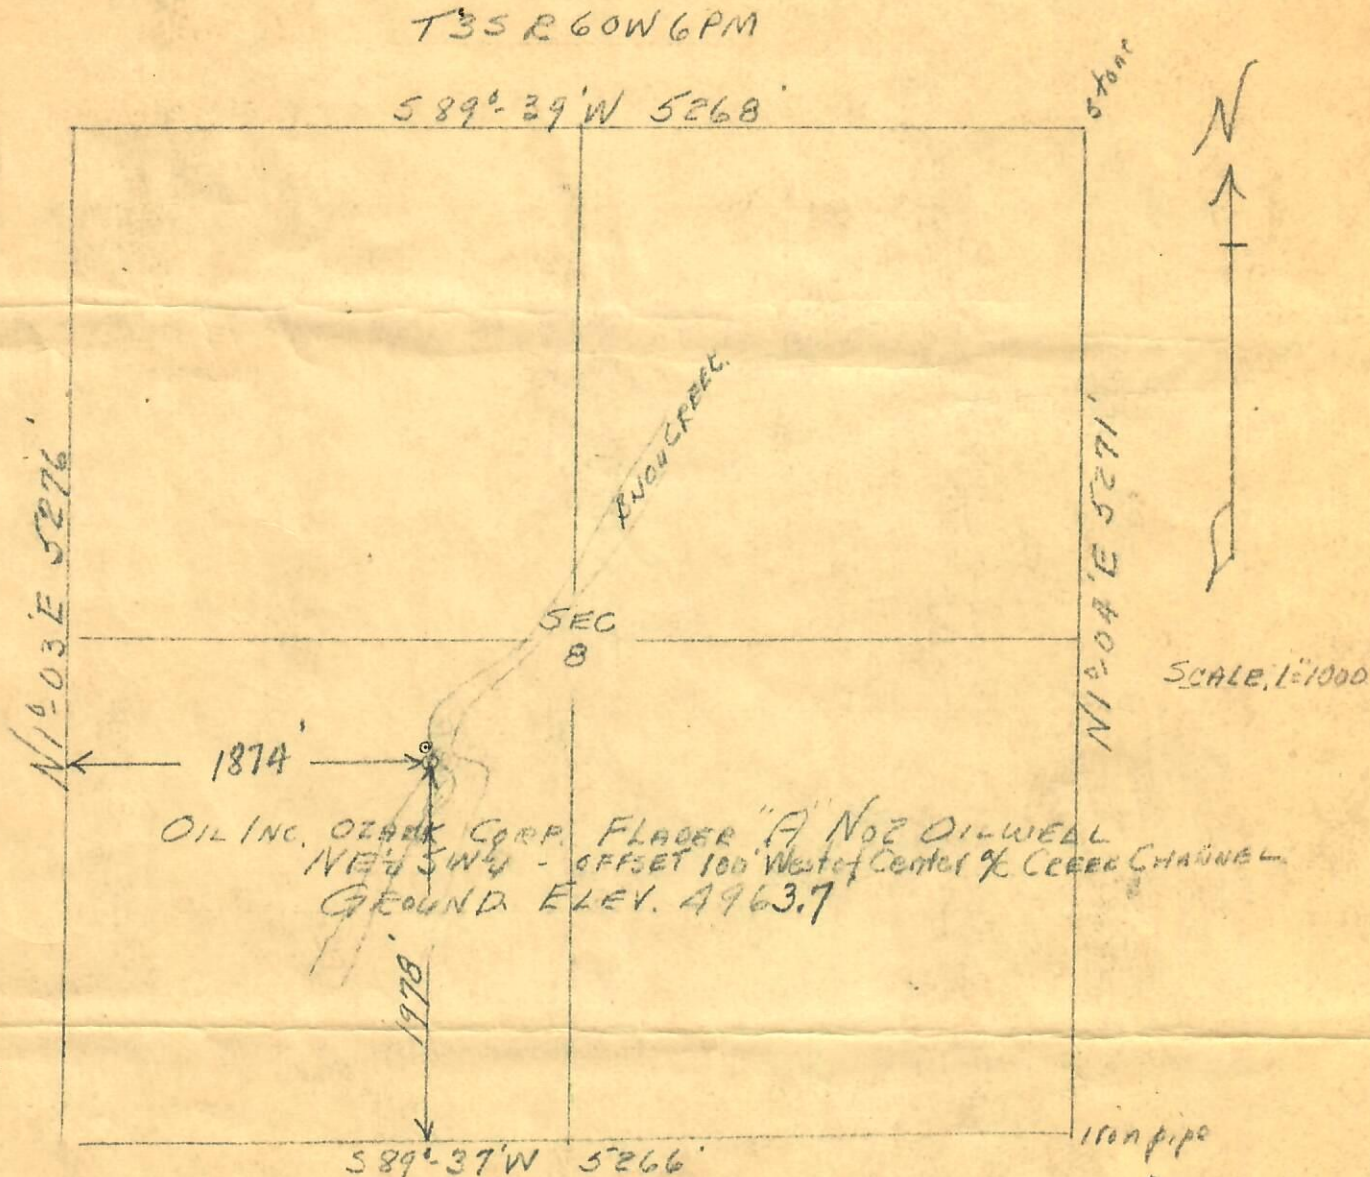


CERTIFICATE OF SURVEY
for
Oil Inc., Ozark Corp.
Adams County, Colorado

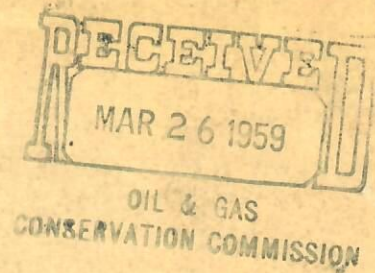

I hereby certify that the above plat is an accurate representation of a correct survey showing the location of Oil Inc., Ozark Corp. - Flader "A" No. 2 Oilwell in NE 1/4 SW 1/4 Sec. 8 T3S R60W 6PM. The elevation of the ground at the stake is 4963.7 feet above sea level from U.S.G.S. Bench Mark. The true center of NE 1/4 SW 1/4 fell in the bed of a running stream, Bijou Creek.

Fort Morgan, Colorado
March, 15, 1959

Cecil J. Osborne
Registered Professional Engineer
State of Colorado.

Please Note: Due to river and quicksand this location was moved 20' west and 55' north. Which makes it 1854' East of the West line and 2033' North of the South Line. Brinkerhoff Drilling Company.