




RECEIVED
OCT 23 1973
COLO. OIL & GAS COM. CO. 4.

R. 61W

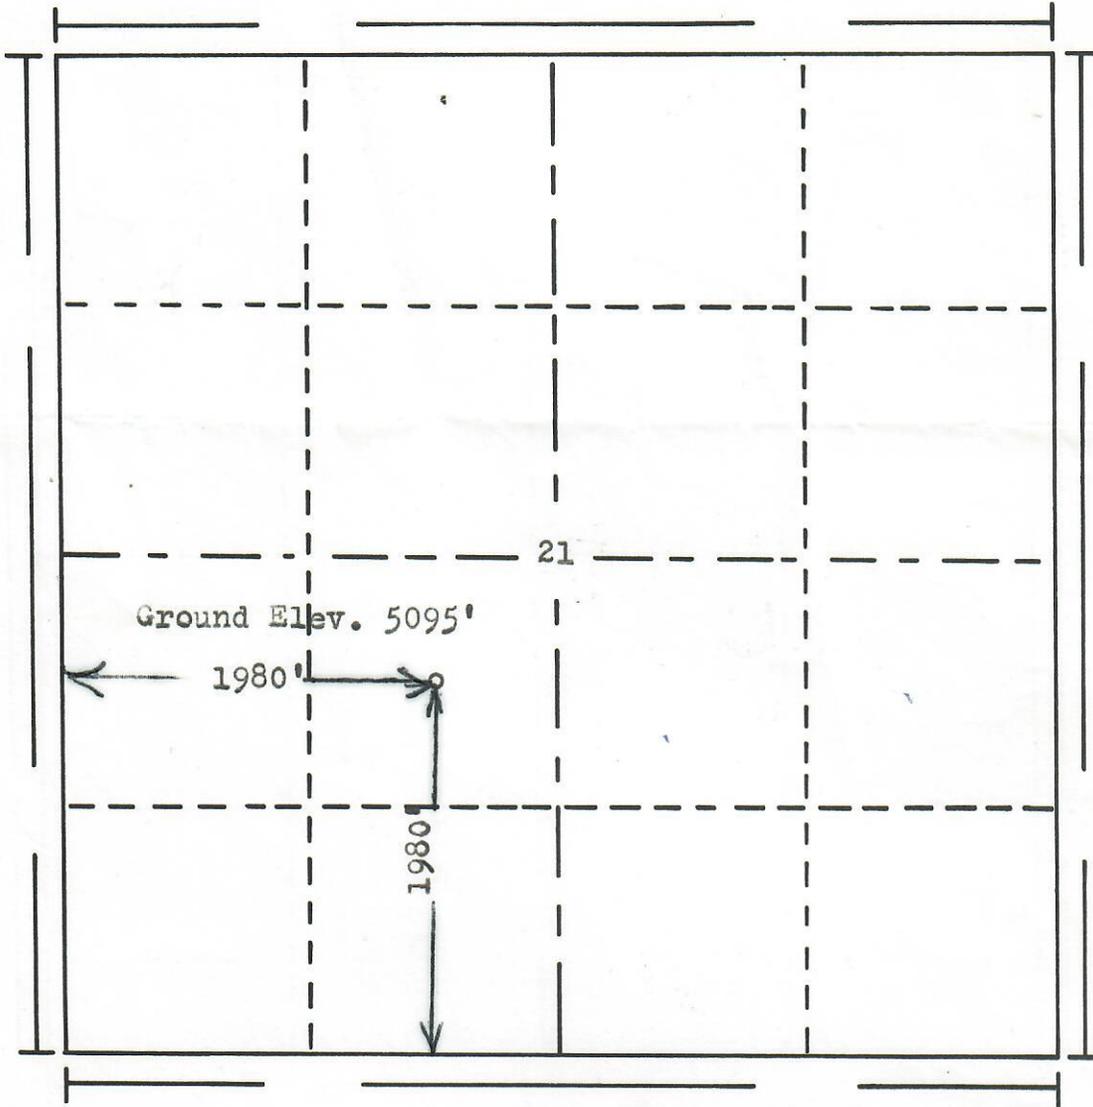

T.
3
S

Scale... 1" = 1000'

Powers Elevation Company, Inc. of Denver, Colorado
 has in accordance with a request from **Mr. Drenner**
 for **Mitchell Energy & Development Corp.**
 determined the location of **No. 2 UPRR-Carlson**
 to be **1980' FS & 1980' FW**
Range 61W of the **6th Principal Meridian** **Section 21 Township 3S**
Adams County, Colorado

I hereby certify that this plat is an accurate representation of a correct survey showing the location of

Date: 10-5-73

Brian H. Hollaway
 Licensed Land Surveyor No. 2853
 State of Colorado

