




P&A Wellbore For State

Well Name: GREEN USX EE13-13

Land, Original Hole, 7/25/2022 7:51:54 PM

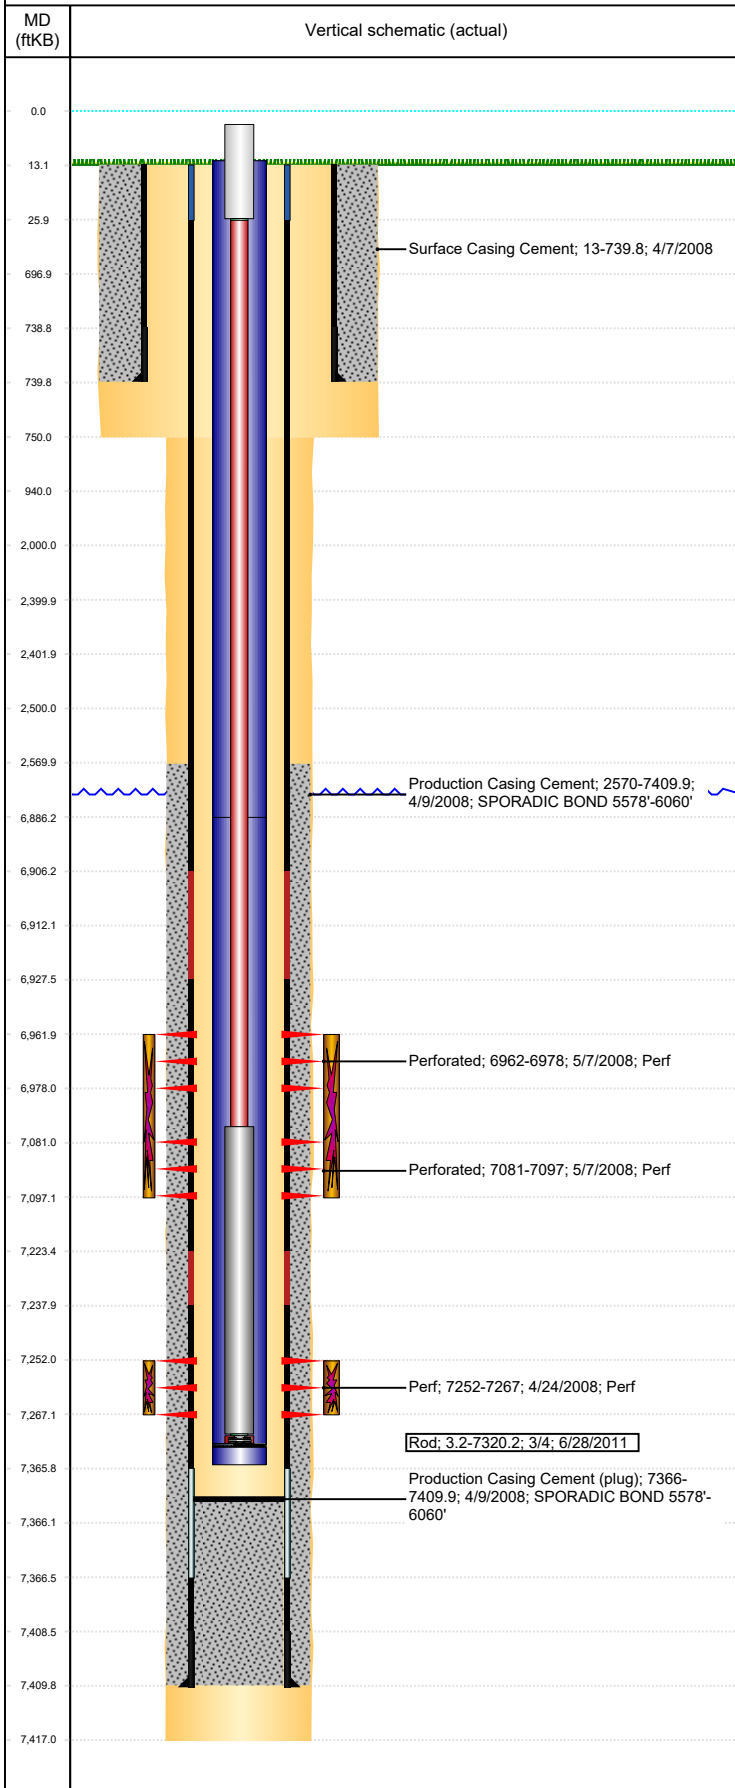

Well Header									
Surface UWI 0512325588			Business Unit Rockies			Gov Auth Dist		Prod Tree Loc Land	
Orig. KB to Gnd (ft) 13.00		Original Spud Date 4/6/2008		Abandon Date		Well Sub-Status TA (AT SURFACE)			High... N
Comment									
Surface Location (Congressional)									
Qtr 3 SW	Qtr 4 SW	Section 13	Twonshp 7	Twonsh... N	Range 65	Rng E/... W	Latitude (°) 40.56785283 9	Longitude (°) -104.617927734	
Wellbore Sections									
Section Des			Hole Size (in)			Act Top (ftKB)		Act Btm (ftKB)	
SURFACE			12 1/4			13.0		750.0	
PRODUCTION			6 1/4			750.0		7,417.0	
Casing Strings									
Csg Des		Run Date		OD (in)	Wt/Len (lb/ft)	Grade	Top Depth (MD) (ftKB)	Set Depth (MD) (ftKB)	
Surface		4/6/2008		8 5/8	24.00	J-55	0	739.8	
Production Casing		4/9/2008		4 1/2	11.60	M-80	13	7409.9	
Cement									
Des				Start Date		Top (ftKB)		Btm (ftKB)	
Surface Casing Cement				4/7/2008		13.0		739.8	
Production Casing Cement				4/9/2008		2,570.0		7,409.9	
Zone Statuses									
Zone Name		Status Date	Status	Fluid Type	Job			Prod Method	
NIOBRARA		6/3/2008	PR		DRILLING/COMPLETION - ORIGINAL, 4/6/2008...				
CODELL		6/3/2008	PR		DRILLING/COMPLETION - ORIGINAL, 4/6/2008...				
Perforation Data									
Linked Zone			Explosive Type	Entered Shot Total	Top (ftKB)		Btm (ftKB)		Date
NIOBRARA, Original Hole			A	64	6,962.0		6,978.0		5/7/2008
NIOBRARA, Original Hole			B	64	7,081.0		7,097.0		5/7/2008
CODELL, Original Hole				60	7,252.0		7,267.0		4/24/2008
Stimulation Intervals									
Zone				Start Date		Top (ftKB)		Btm (ftKB)	
NIOBRARA, Original Hole				5/7/2008		6,962.0		7,097.0	
CODELL, Original Hole				5/7/2008		7,252.0		7,267.0	
Other In Hole									
Run Date		Des			Make		OD (in)	Top (ftKB)	Btm (ftKB)
Logs									
Date		Type				Depth Top (MD) (ftKB)		Btm (ftKB)	
4/9/2008		Caliper/Comp. Density/Neutron/GR				2,890		7,397.0	
4/9/2008		DIL/GR/SP/Caliper				740		7,417.0	
4/22/2008		CBL/CCL/GR				2,480		7,326.0	
Plug Back Total Depths									
Date		Type			Com				PBTD (ftKB)
6/30/2008		FILL							7,353
6/27/2011		FILL			C/O TO 7366' KB				7,366