


N

Keller Cattle Co. 24-14

7/28/2022 @ 8:30 Am

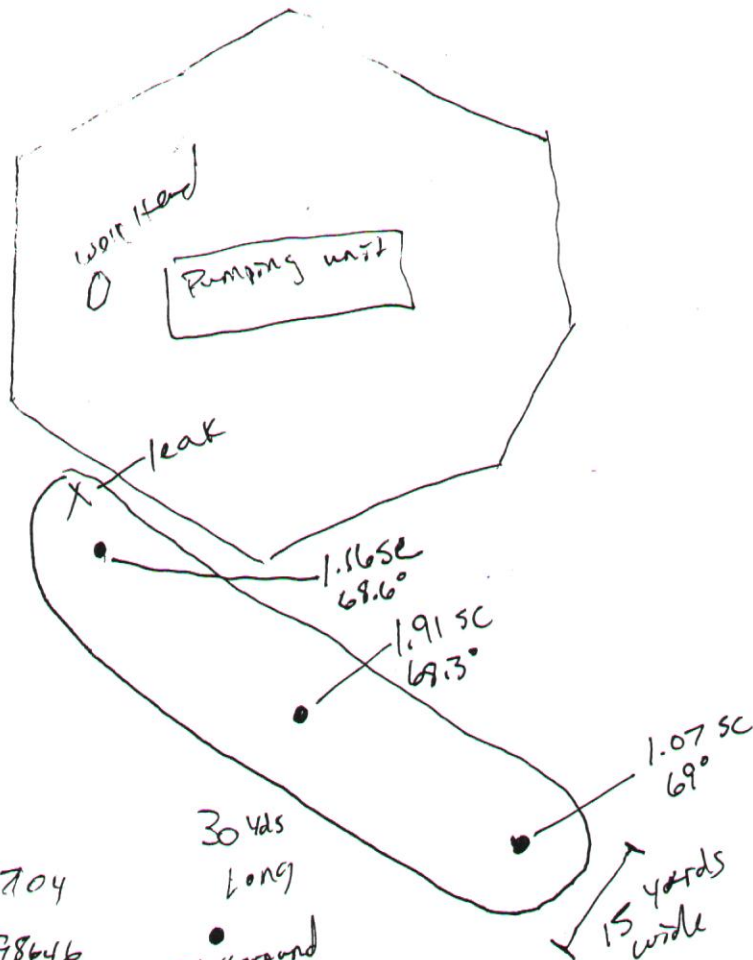

#1 39.87704

102.498646

#2 39.872077

102.498598

#3 39.877012

102.498485

#4 39.877006

102.498610

30 yds
Long
●
Background
Test
0.07 SC
70°