



FORM F-106




00326244

RECEIVED

JUL 2 1974

R. 60W  
16277

COLO. OIL &amp; GAS CONS. COMM.

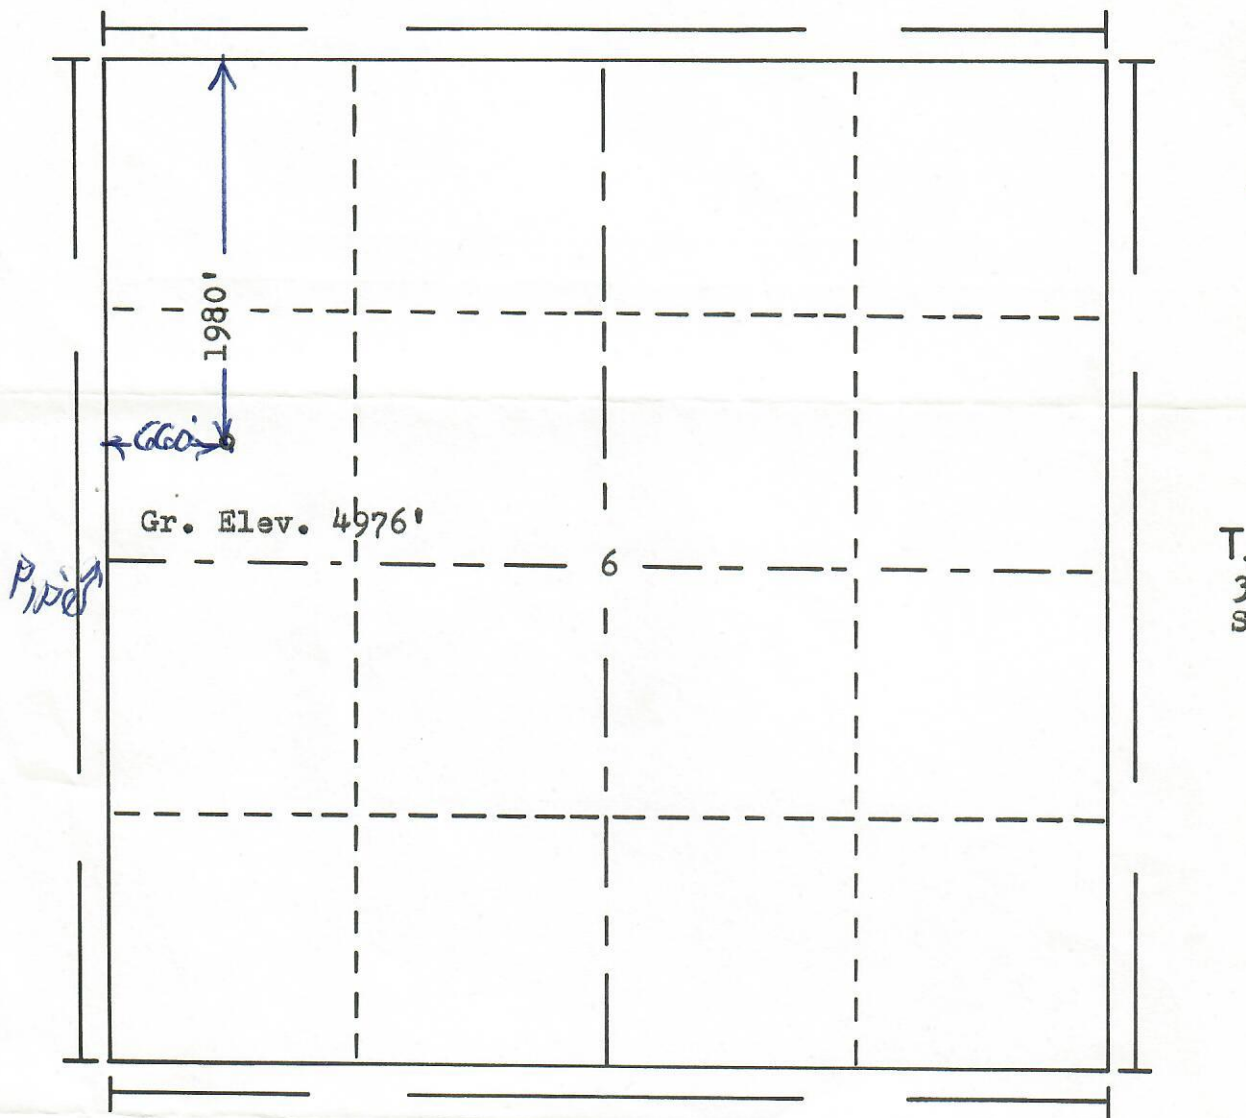

Scale... 1" = 1000'

Powers Elevation Company, Inc. of Denver, Colorado  
has in accordance with a request from Mr. Mossel  
for Tom Jordan  
determined the location of No.1 Flader Industries Inc.  
to be CSW NW Section 6 Township 3S  
Range 60W of the 6th Principal Meridian  
Adams County, Colorado

I hereby certify that this plat is an  
accurate representation of a correct  
survey showing the location of

Date: 6-25-74

*B. J. Holloway*  
Licensed Land Surveyor No. 2853  
State of Colorado