




R. 61W

RECEIVED

JUN 18 1973

COLORADO OIL & GAS CONS. COMM.

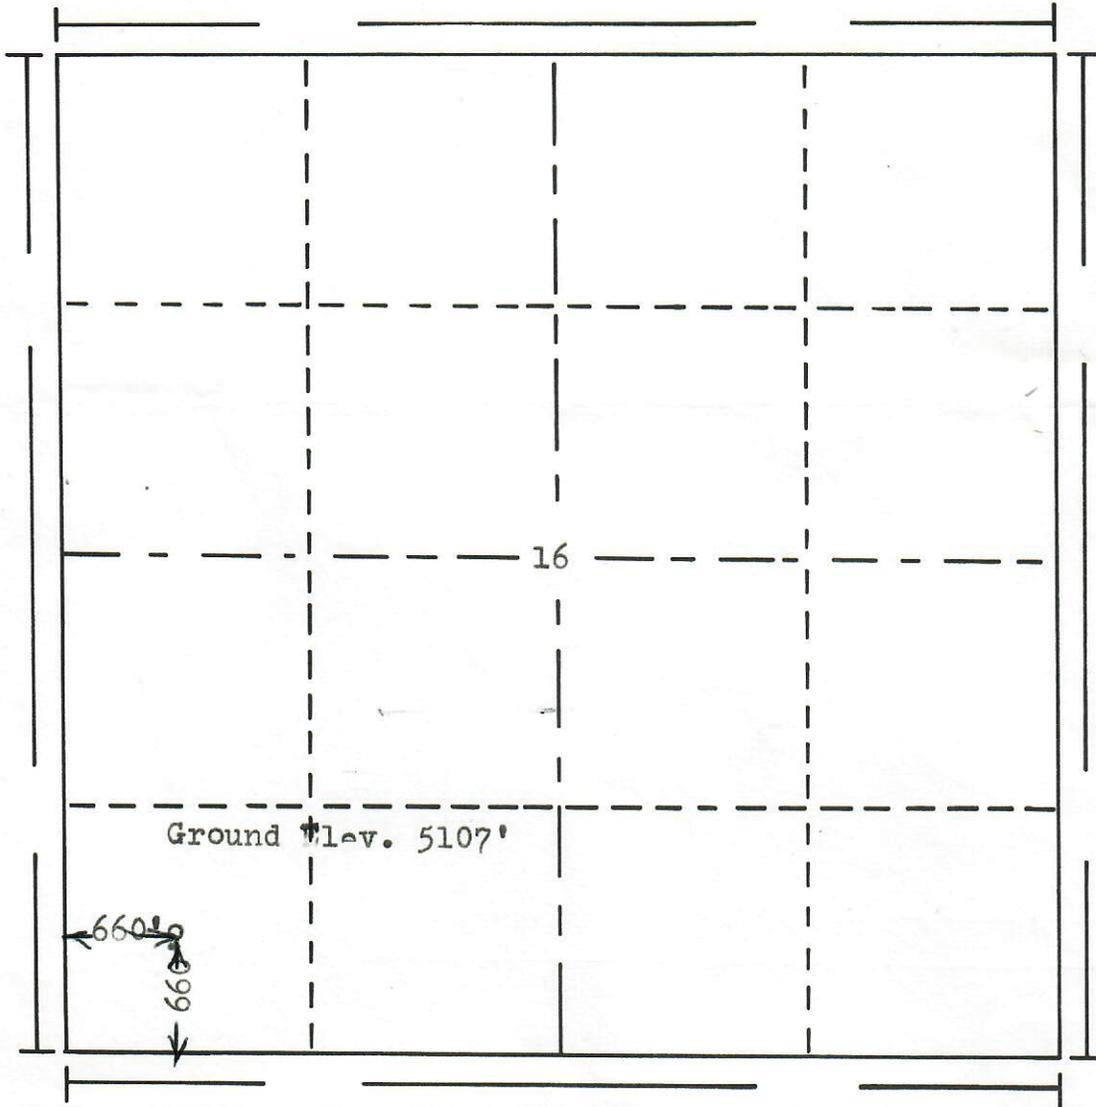

T. 33

Scale... 1" = 1000'

Powers Elevation Company, Inc. of Denver, Colorado
 has in accordance with a request from Mr. Drenner
 for Mitchell Energy & Development Corp.
 determined the location of No. 1 State of Colorado
 to be CSW SW Section 16 Township 33
 Range 61W of the 6th Principal Meridian
Adams County, Colorado



I hereby certify that this plat is an accurate representation of a correct survey showing the location of

Date: 6-5-73

William B. Hull

 Licensed Land Surveyor No. 2853
 State of Colorado