



FORM F-106




00396224

RECEIVED

JUL 29 1971

COLO. OIL & GAS CONS. COMM.

R. 61W

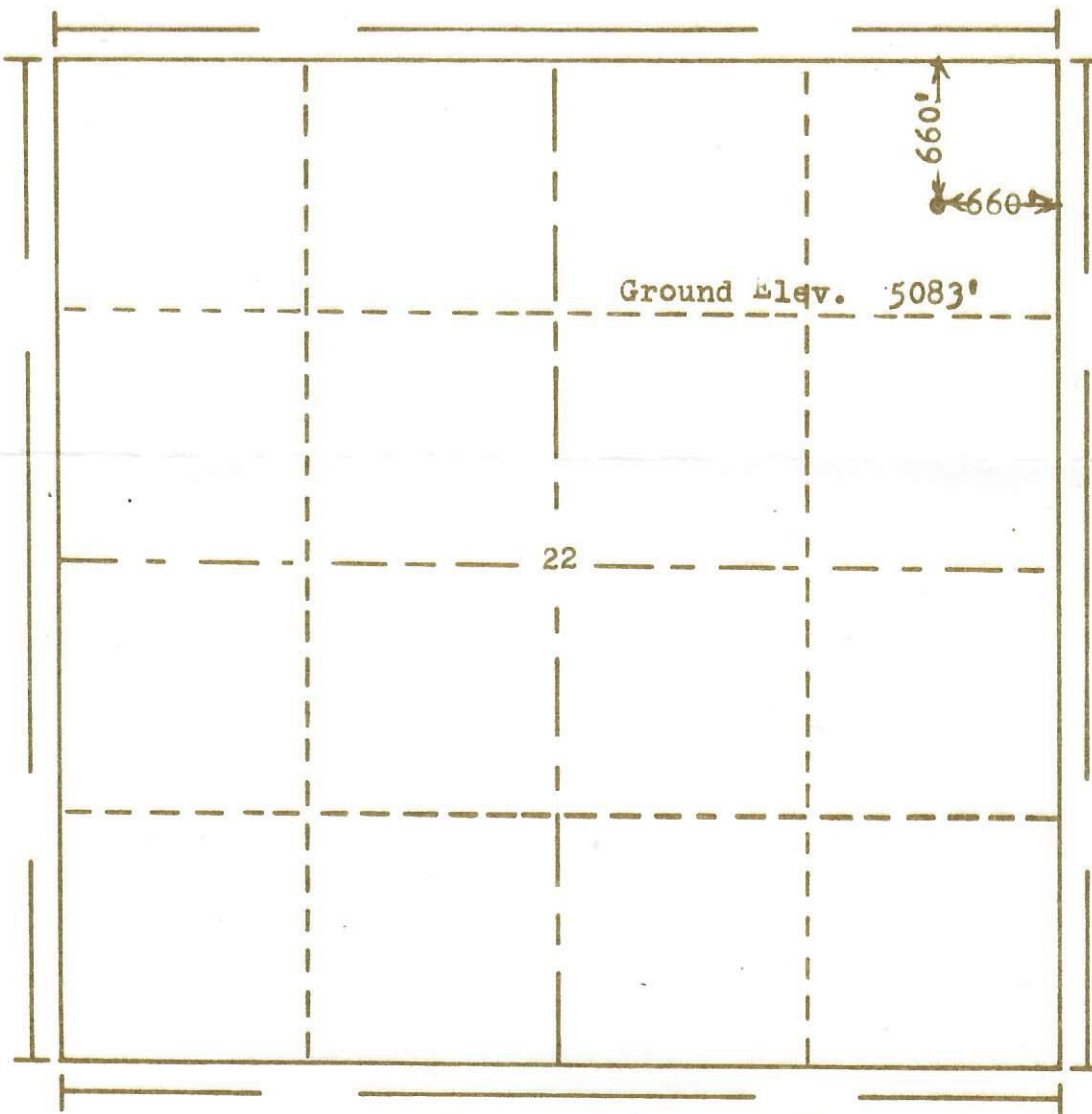

Scale... 1" = 1000'

Powers Elevation Company, Inc. of Denver, Colorado
has in accordance with a request from Mr. Gasch
for Toltek Drlg. Co.
determined the location of No. 1-22 Hanlon
to be CNE NE Section 22 Township 3S
Range 61W of the 6th Principal Meridian
Adams County, Colorado

I hereby certify that this plat is an
accurate representation of a correct
survey showing the location of

Date: 7-23-71

Lee H. Hoover
Licensed Land Surveyor No. 2853
State of Colorado

71-541