




00416789

RECEIVED

OCT 22 1971

R. 59W COLO. OIL & GAS CONS. COMM.

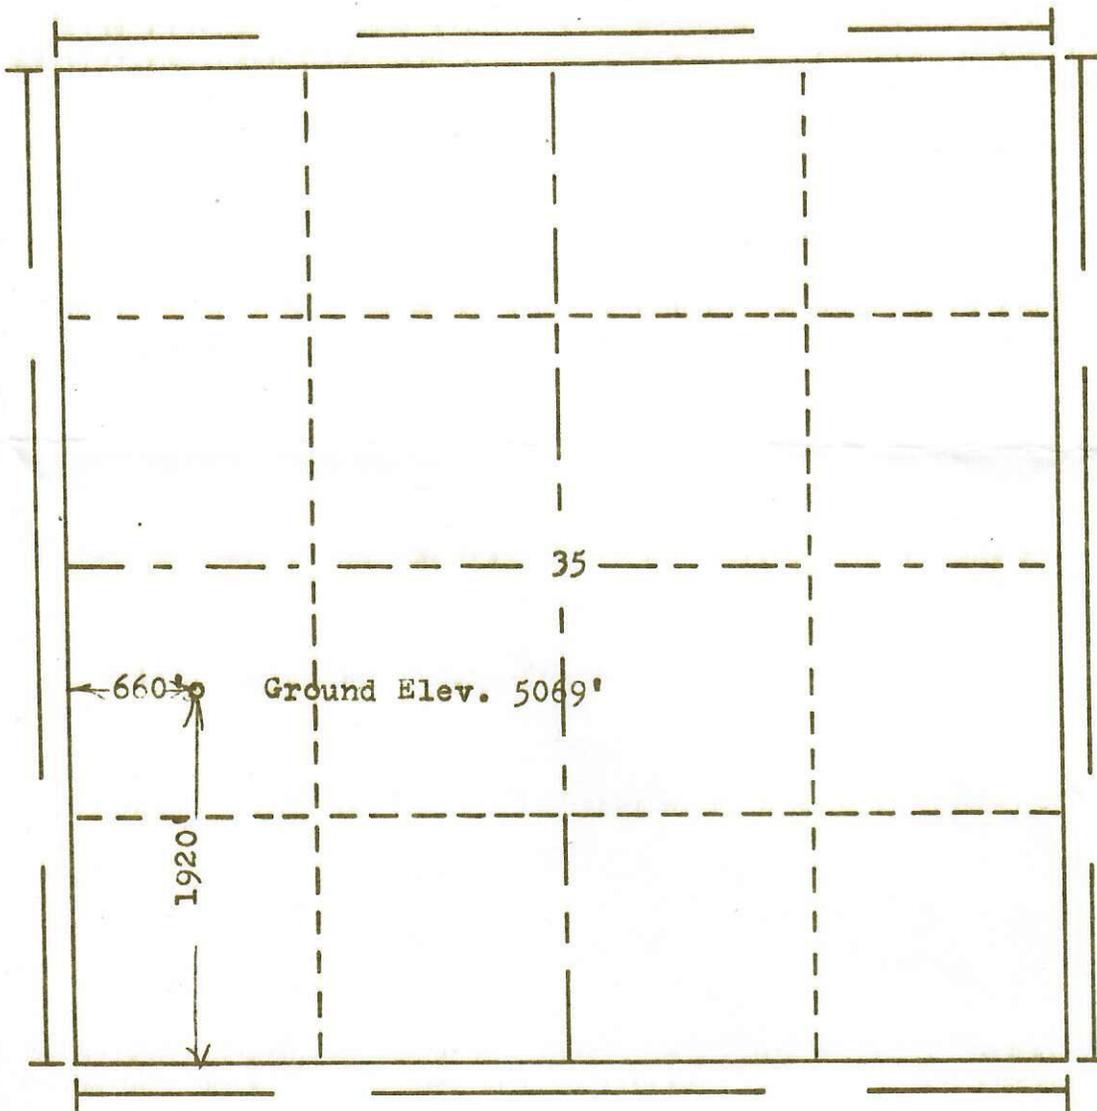

T.  
3  
S

Scale... 1" = 1000'

Powers Elevation Company, Inc. of Denver, Colorado has in accordance with a request from Mr. Repp for Amoco Production Co.

determined the location of 64 UPRR Amoco B-1 to be CNW SW Section 35 Township 3S Range 59W of the 6th Principal Meridian Adams County, Colorado

I hereby certify that this plat is an accurate representation of a correct survey showing the location of

71-809

Date: 10-16-71

Ray G. Hoag  
Licensed Land Surveyor No. 2853  
State of Colorado