




P&A Wellbore For State

Well Name: HANSCOME C28-30D

Land, Original Hole, 8/9/2022 1:11:27 PM

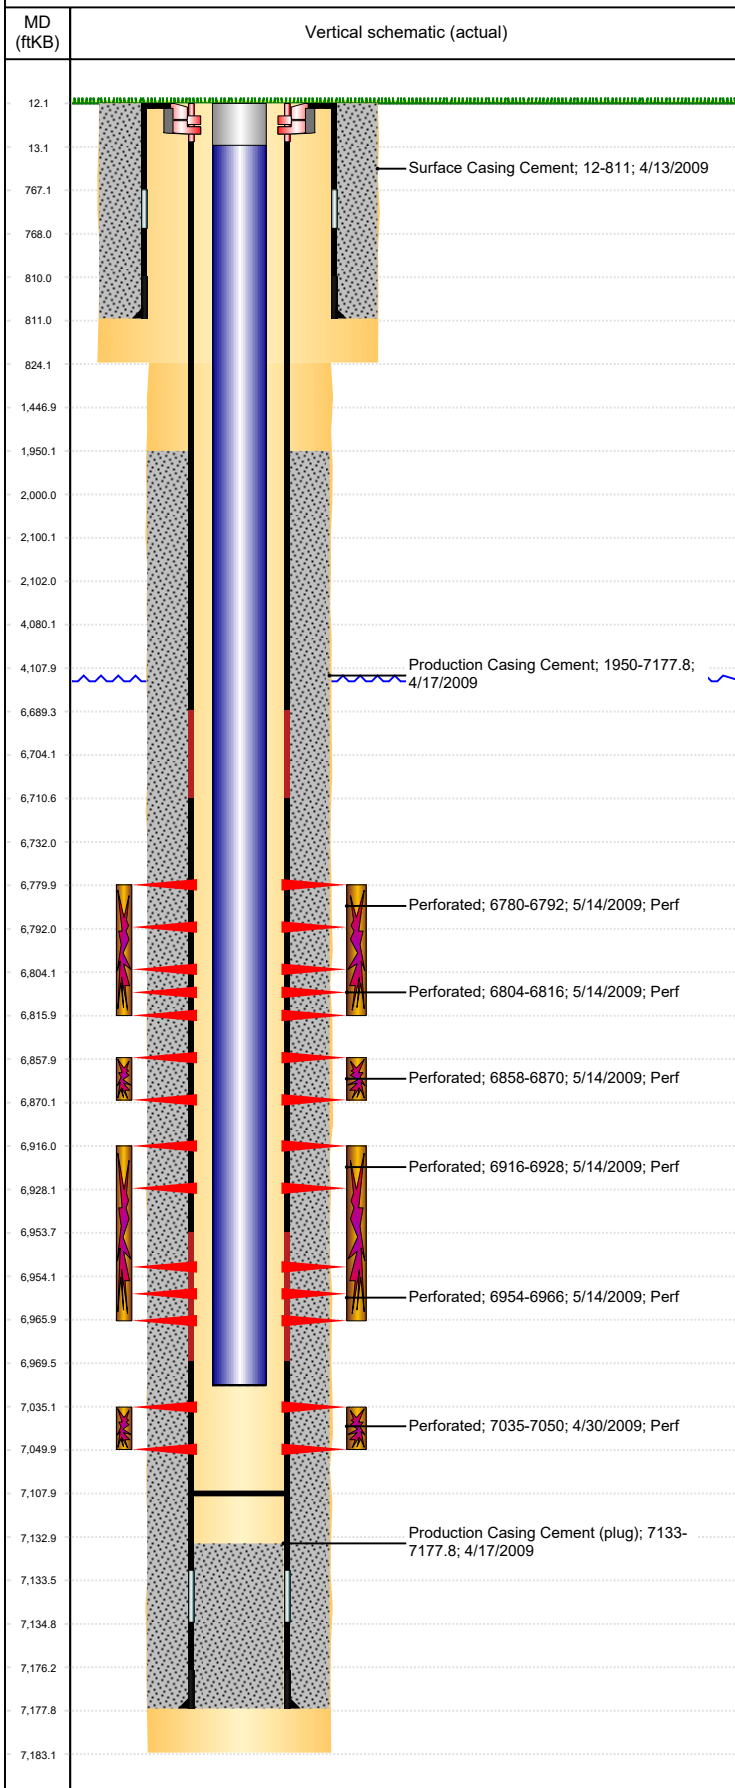

Well Header									
Surface UWI 0512329204			Business Unit Rockies			Gov Auth Dist		Prod Tree Loc Land	
Orig. KB to Gnd (ft) 12.00		Original Spud Date 4/13/2009		Abandon Date		Well Sub-Status SI			High... N
Comment 318A.e LOCATION. DIRECTIONAL WELL									
Surface Location (Congressional)									
Qtr 3 SE	Qtr 4 SE	Section 20	Twonshp 4	Twonsh... N	Range 64	Rng E/... W	Latitude (°) 40.29252951	Longitude (°) -104.567313903	
Wellbore Sections									
Section Des			Hole Size (in)			Act Top (ftKB)		Act Btm (ftKB)	
SURFACE			12 1/4			12.0		824.0	
PRODUCTION			7 7/8			824.0		7,183.0	
Casing Strings									
Csg Des			Run Date		OD (in)	Wt/Len (lb/ft)	Grade	Top Depth (MD) (ftKB)	Set Depth (MD) (ftKB)
Surface			4/13/2009		8 5/8	24.00	J-55	12	811
Production Casing			4/16/2009		4 1/2	11.60	M-80	12	7177.8
Cement									
Des					Start Date		Top (ftKB)		Btm (ftKB)
Surface Casing Cement					4/13/2009		12.0		811.0
Production Casing Cement					4/17/2009		1,950.0		7,177.8
Zone Statuses									
Zone Name		Status Date		Status	Fluid Type		Job		Prod Method
CODELL		10/24/2009		PR	Gas		DRILLING/COMPLETION - ORIGINAL, 4/12/2009...		Flowing
CODELL		4/23/2010		PR					
NIOBRARA		10/24/2009		PR			DRILLING/COMPLETION - ORIGINAL, 4/12/2009...		Flowing
NIOBRARA		4/23/2010		PR					
Perforation Data									
Linked Zone				Explosive Type	Entered Shot Total	Top (ftKB)		Btm (ftKB)	Date
NIOBRARA, Original Hole				A	24	6,780.0		6,792.0	5/14/2009
NIOBRARA, Original Hole				A	24	6,804.0		6,816.0	5/14/2009
NIOBRARA, Original Hole				B	24	6,858.0		6,870.0	5/14/2009
NIOBRARA, Original Hole				C	24	6,916.0		6,928.0	5/14/2009
NIOBRARA, Original Hole				C	24	6,954.0		6,966.0	5/14/2009
CODELL, Original Hole					60	7,035.0		7,050.0	4/30/2009
Stimulation Intervals									
Zone					Start Date		Top (ftKB)		Btm (ftKB)
NIOBRARA, Original Hole					5/14/2009		6,780.0		6,816.0
NIOBRARA, Original Hole					5/14/2009		6,858.0		6,870.0
NIOBRARA, Original Hole					5/14/2009		6,916.0		6,966.0
CODELL, Original Hole					5/14/2009		7,035.0		7,050.0
Other In Hole									
Run Date		Des			Make		OD (in)	Top (ftKB)	Btm (ftKB)
Logs									
Date		Type					Depth Top (MD) (ftKB)		Btm (ftKB)
4/16/2009		SPECTRAL DENSITY/Pe/DSN NEUTRON/SP/ARRAY COMPENSATED TRUE RESISTIVITY/6 ARM CALIPER					6,380		7,183.0
4/16/2009		SPECTRAL GAMMA RAY					810		7,151.0
4/28/2009		CBL/CCL/GR					1,754		7,093.0
Plug Back Total Depths									
Date		Type			Com				PBTD (ftKB)
6/3/2009		PLUG			C/O TO CIBP.				6,987
10/20/2009		PLUG REMNANTS							7,108