




RECEIVED

FEB -6 1970

COLO. OIL & GAS CONS. COMM.

R. 61W

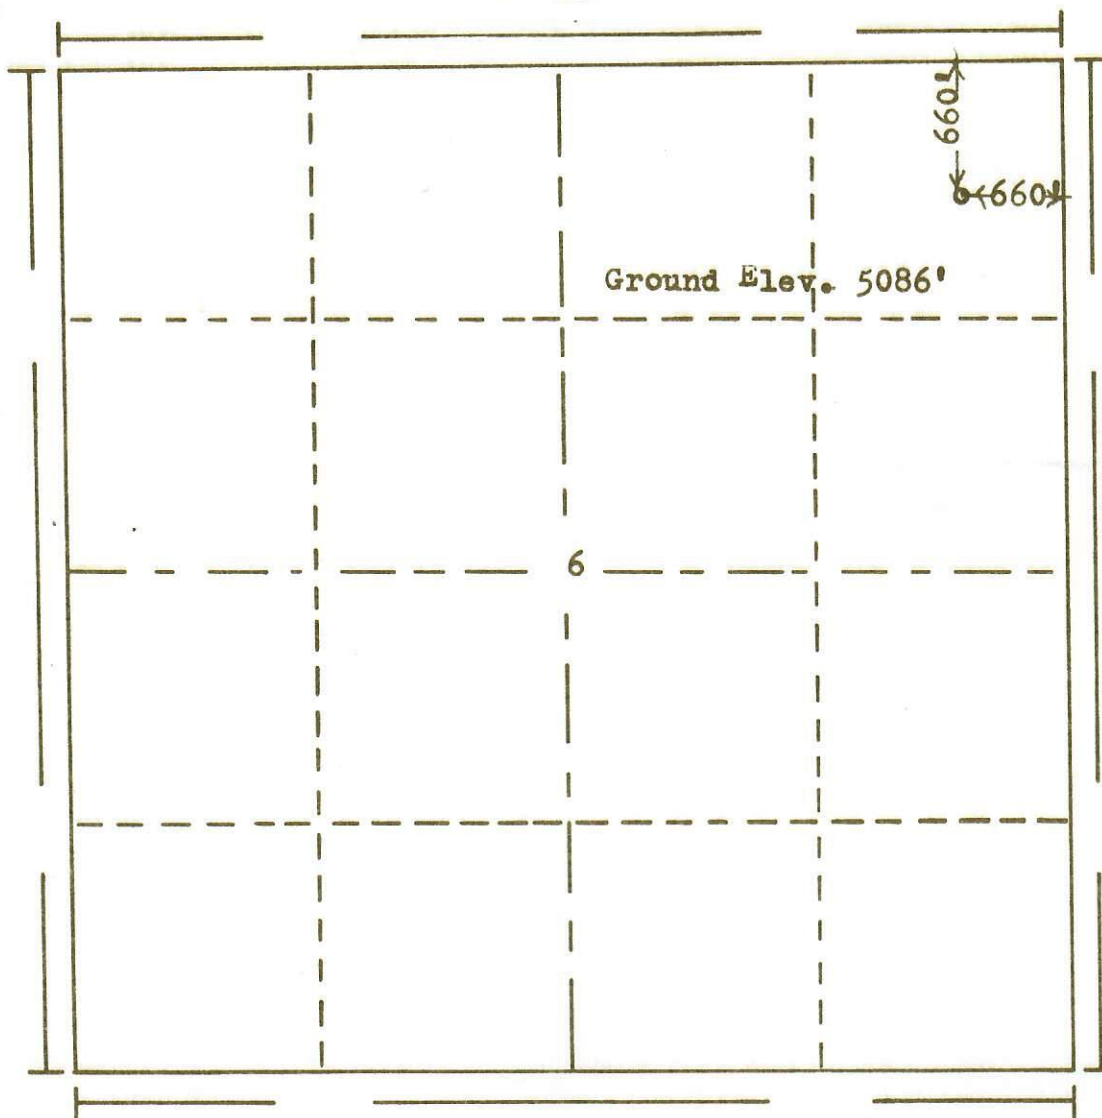

Scale... 1" = 1000'

Powers Elevation Company, Inc. of Denver, Colorado
has in accordance with a request from Ruth Whitsell
for Union Texas Petroleum
determined the location of No.1 Ferguson
to be CNE NE Section 6 Township 3S
Range 61W of the 6th Principal Meridian
Adams County, Colorado

I hereby certify that this plat is an
accurate representation of a correct
survey showing the location of

70 51

Date 1-19-70

David J. Hickey
Licensed Land Surveyor No. 2853
State of Colorado