

RECEIVED


FEB -6 1970

COLO. OIL & GAS CONS. COMM.



00396134

61W

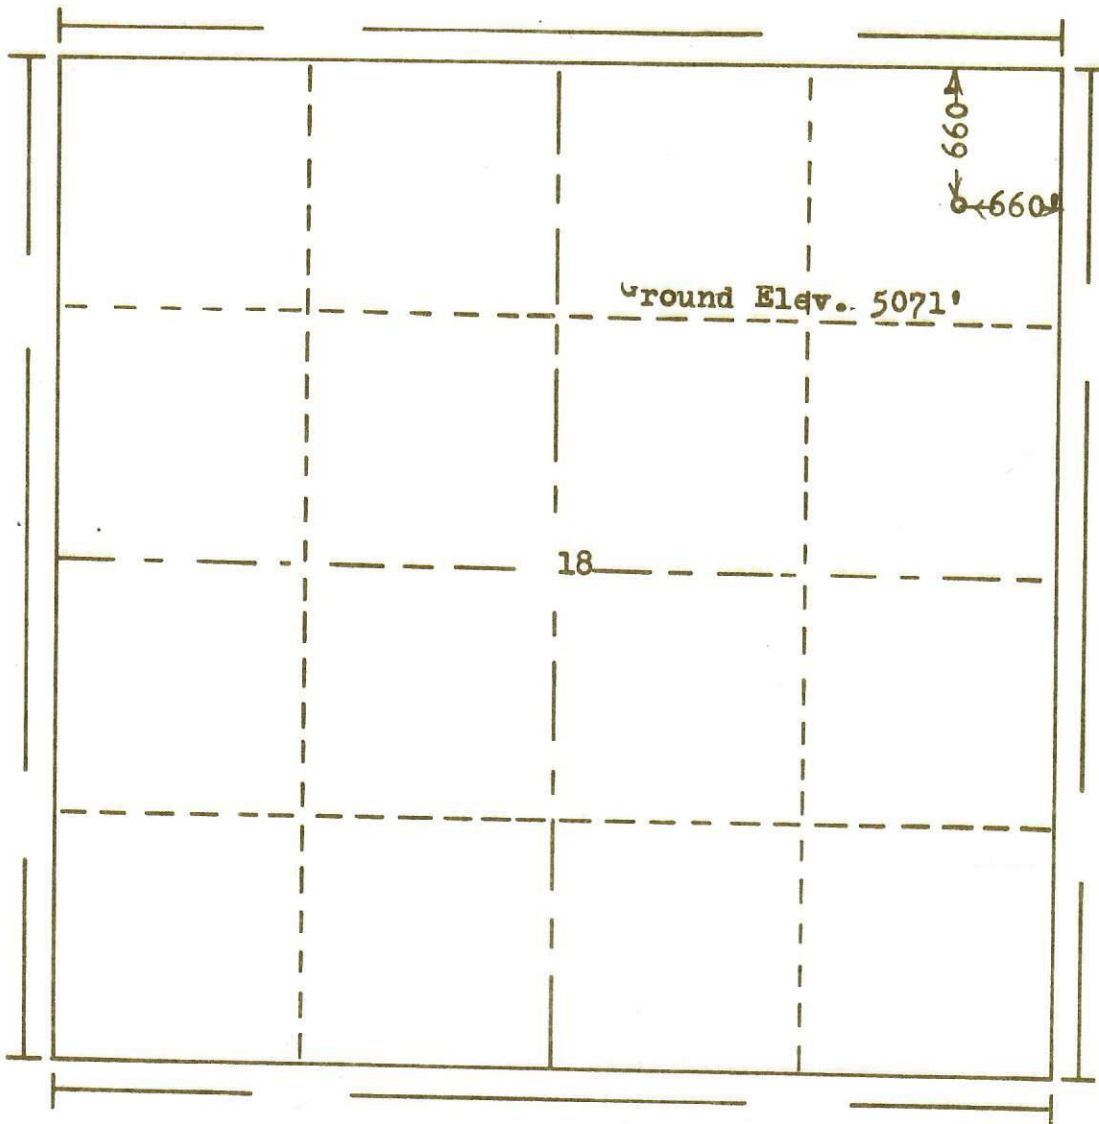

Scale... 1" = 1000'

Powers Elevation Company, Inc. of Denver, Colorado  
has in accordance with a request from Ruth Whitsell  
for Union Texas Petroleum  
determined the location of No.1 Tippet  
to be CNE NE Section 18 Township 38  
Range 61W of the 6th Principal Meridian  
Adams County, Colorado

70 52

I hereby certify that this plat is an  
accurate representation of a correct  
survey showing the location of

Date: 1-19-70

Kevin J. Hollman  
Licensed Land Surveyor No. 2853  
State of Colorado