




# Downhole Well Profile

Well Name: DRAGON TRAIL UN 1142 1993 DRL100%

API/UWI 05103096040000	Surface Legal Location NWSE-S27-T2S-R102W-6PM	Field Name Dragon Trail	License #	State/Province CO	Well Configuration Type Vertical
Original KB Elevation (ft) 7,091	KB-Tubing Head Distance (ft) 10	Spud Date 6/4/1993 00:00	Rig Release Date 6/25/1993 00:00	PBTD (All) (ftKB) Original Hole - 3,093.0	Total Depth All (TVD) (ftKB) Original Hole - 3,167.0

Type						
Des	Make	Model	WP (psi)	Service	WP Top (psi)	Bore Min (in)

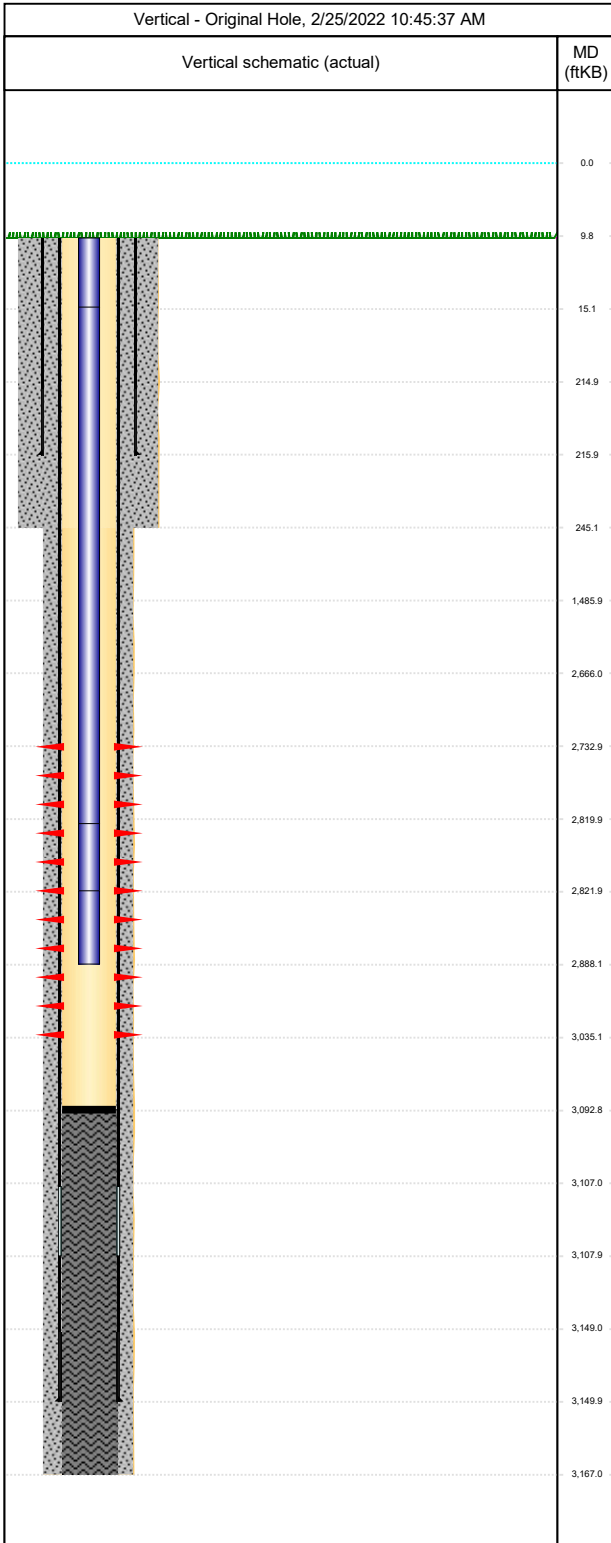

Casing Strings							
Csg Des	OD (in)	Wt/Len (lb/ft)	Grade	Top Thread	Set Depth (ftKB)		
Surface	8 5/8	24.00	J-55	ST&C	216.0		
Production	5 1/2	15.50	J-55	LT&C	3,150.0		
Perforations							
Date	Top (ftKB)		Btm (ftKB)		Linked Zone		
6/29/1993	2733		3035		Mancos B, Original Hole		
Tubing Strings							
Tubing Description	Run Date		String Length (ft)		Set Depth (ftKB)		
Tubing - Production	6/29/1993		2,878.00		2,888.0		
Item Des	Jts	Make	Model	OD (in)	Wt (lb/ft)	Grade	Len (ft)
Blast Joint	1			1.9	2.90		5
Tubing	85			1.9	2.90		2805
Flag Pup	1			1.9	2.90		2
Tubing	2			1.9	2.90		66
Rod Strings							
Rod Description	Run Date		String Length (ft)		Set Depth (ftKB)		
Item Des	Jts	Make	Model	OD (in)	Wt (lb/ft)	Grade	Len (ft)